


T.4S.,R.5W.,W.M.

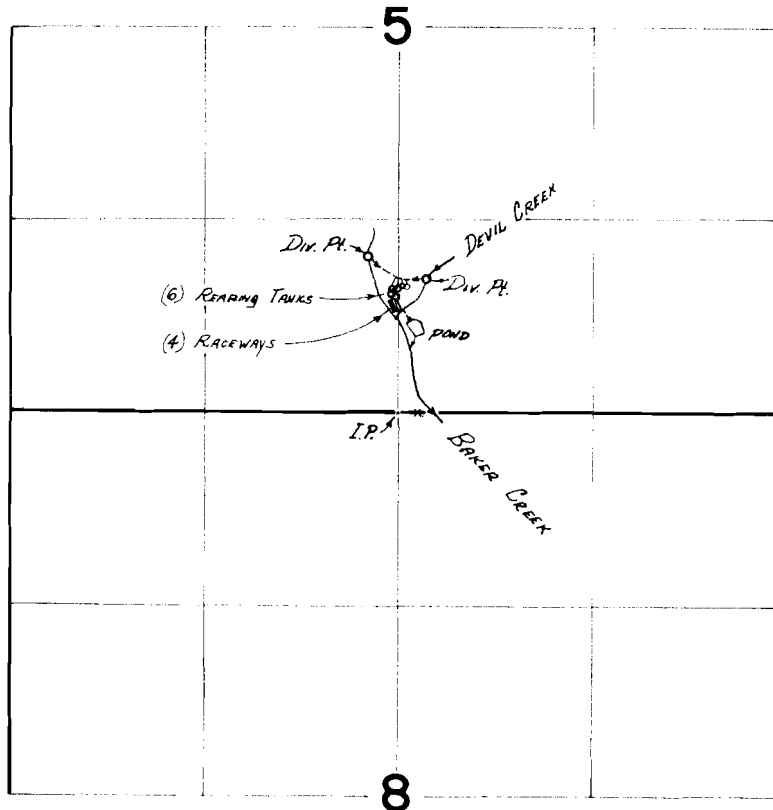

DIV. PTS. LOC.: BAKER Cr.-1070'N. & 200'W.; DEVIL Cr.-910'N. & 190'E.; BOTH FROM S. 1/4 COR. SEC. 5.

FINAL PROOF SURVEY

UNDER

R-38534

38535

R-44217

R-3250

28722

R-5139

Application No. 44218 Permit No. 33136

IN NAME OF

CHARLES J. MCGILL

Surveyed May 7, 1973, by D. NORBY