


T.4S.,R.5W.,W.M.

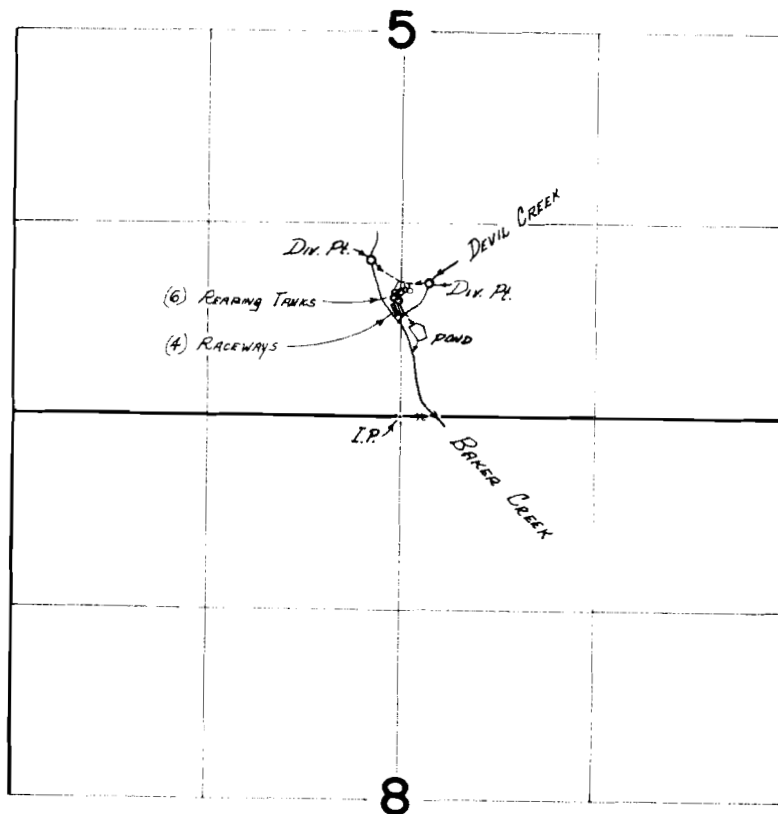

DIV. PTS. LOC.: BAKER Cr.-1070' N. of 200' W.; DEVIL Cr.-910' N. of 190' E.; BOTH
FROM S. 1/4 COR. SEC. 5.

FINAL PROOF SURVEY

UNDER

R-38534

R-3250

38535

28722

R-44217

R-5139

Application No. 44218 Permit No. 33136

IN NAME OF

CHARLES J. MCGILL

Surveyed May 7 1973 by D. NORBY