


T.4S., R.5W., W.M.

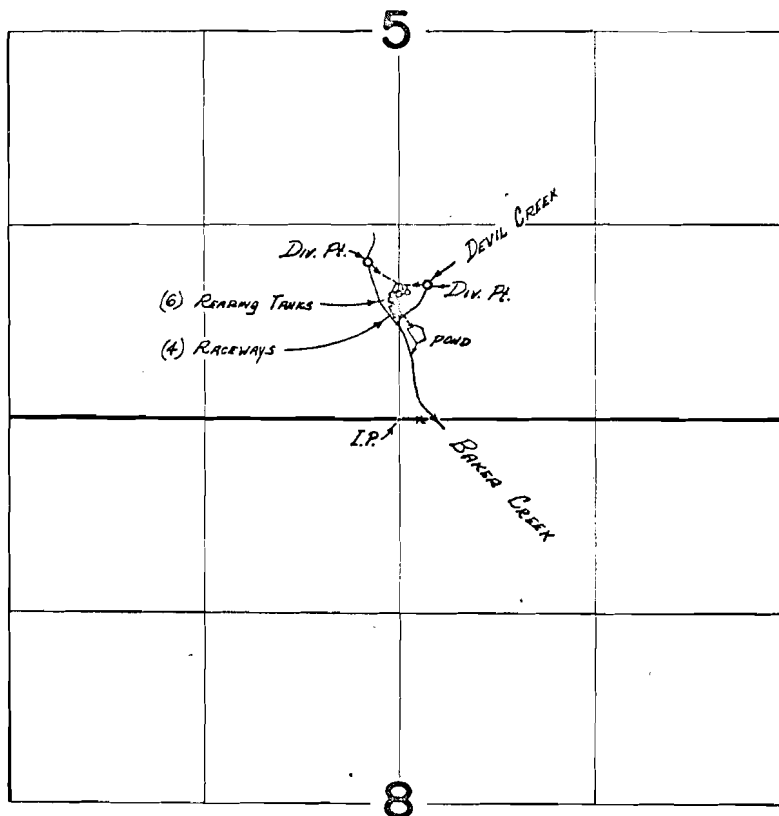

Div. Pts. loc.: Baker Cr.- 1070' N. of 200' W.; Devil Cr.- 910' N. of 190' E.; both from S. 1/4 cor. Sec. 5.

FINAL PROOF SURVEY

UNDER

R-38534

R-3250

38535

28722

R-44217

R-5139

Application No. 44218 Permit No. 33136

IN NAME OF

CHARLES J. MCGILL

Surveyed May 7, 1913, by D. Nease