


T.4S.,R.4W.,WM.

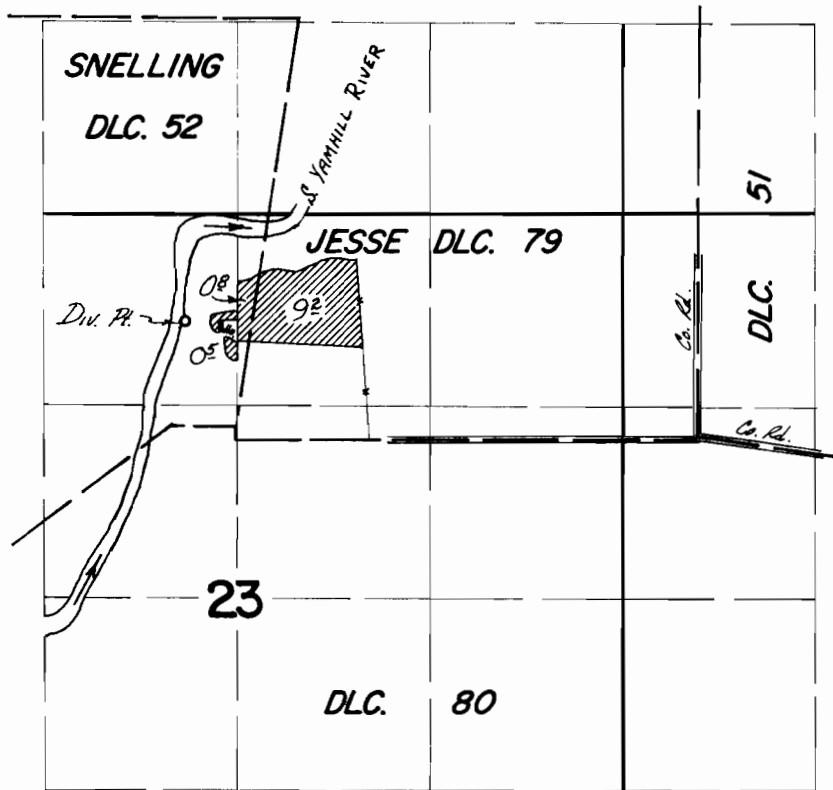

Div. Pt. loc.: 800' N. & 3520' W. FROM SE COR. JESSE DLC. 79.

**FINAL PROOF SURVEY**  
UNDER

Application No. 42208 Permit No. 31051  
IN NAME OF

**ROBERT OLIVER & ESTERINE P. FREDERIKSEN**

Surveyed May 17 1973, by D. NORBY