


T.6S.,R.6W.,W.M.

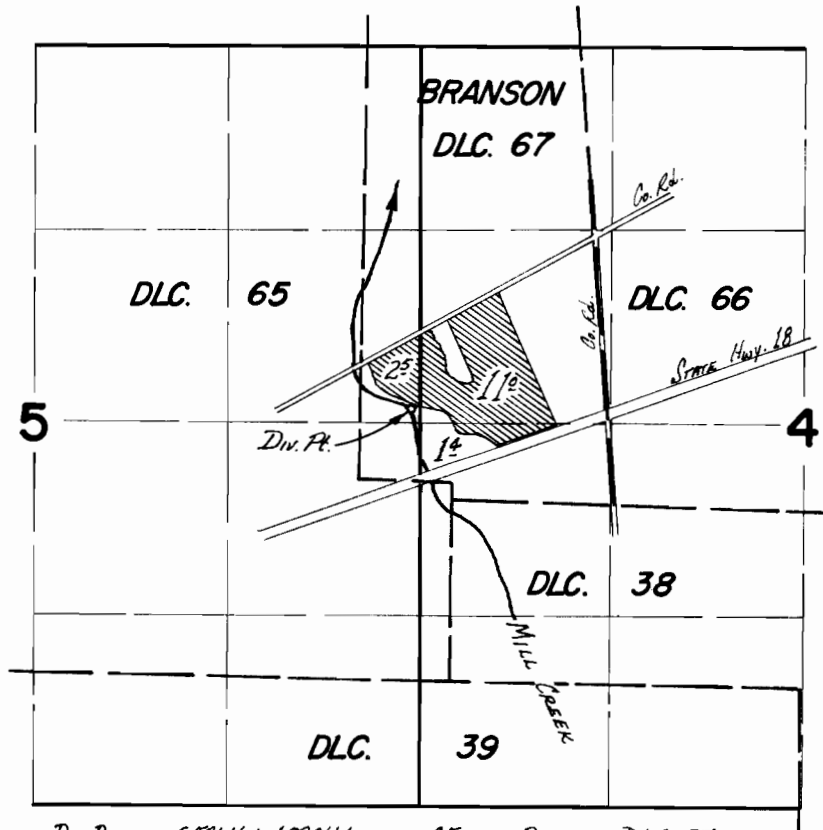

Div. Pt. loc.: 650' N. & 1390' W. FROM SE. COR. BRANSON DLC. 67.

FINAL PROOF SURVEY
UNDER

Application No. 43043 Permit No. 32165
IN NAME OF

LAURA DAVIDSON

Surveyed May 7 1973, by D. NORRIS