


T.5S., R.7W., W.M.

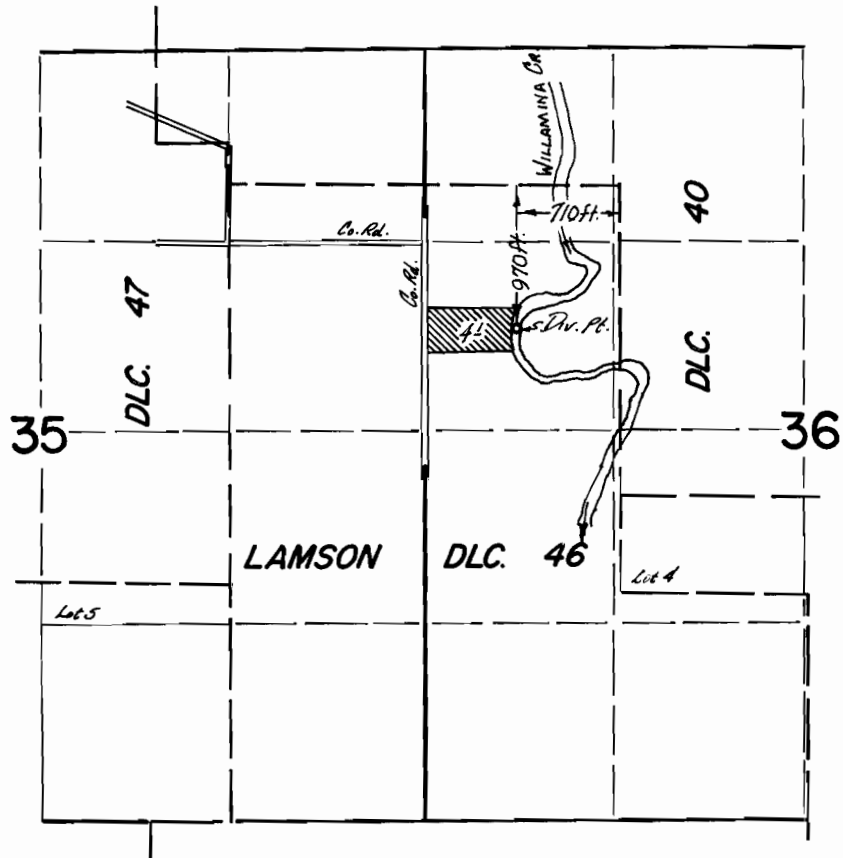

FINAL PROOF SURVEY
UNDER

Application No. 43981 Permit No. 32853
IN NAME OF

KENNETH J. KUHLER

Surveyed 21 JUNE 1972 by D. NORBY