


T.4S.,R.5W.,W.M.

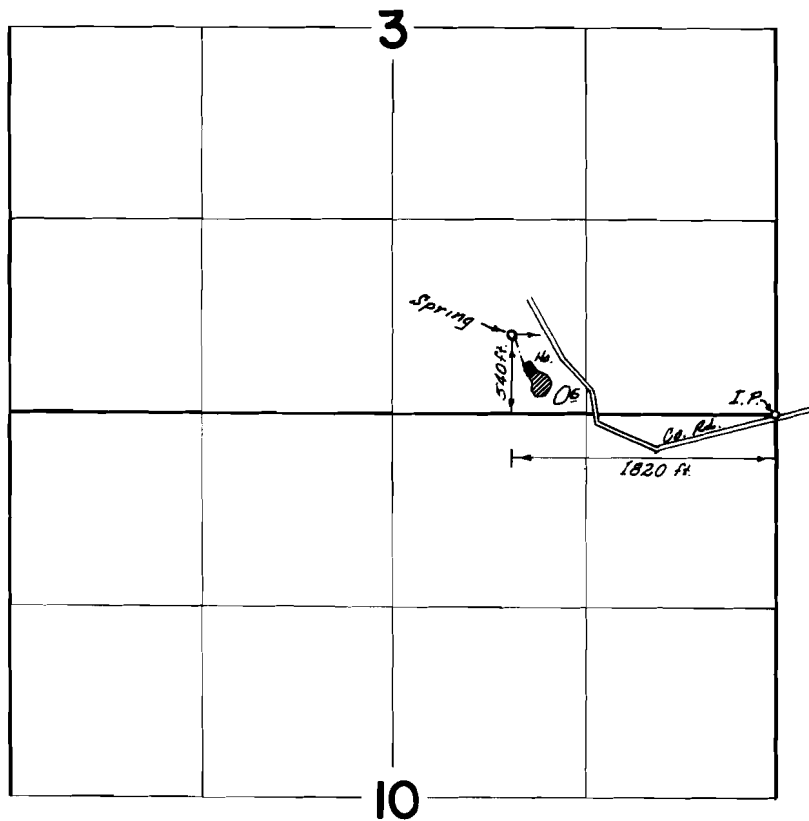

FINAL PROOF SURVEY
UNDER

Application No. 46321 Permit No. 34260
IN NAME OF

WAYNE A. & CAROLE L. BARTON

Surveyed May 11 1973, by D. Norby