


T.2S. R.6E. W.M.

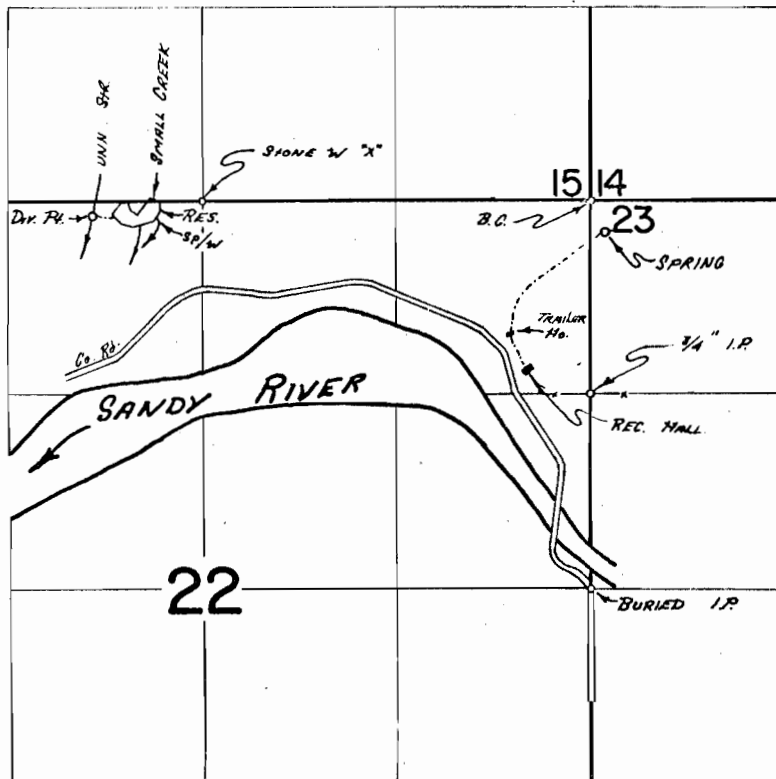

DIV. PT. LOG: 100' S & 750' W FROM N 1/4 COR SEC. 22
 SPRING LOG: 210' S & 100' E FROM NW COR. SEC. 23
 RES. DIV. PT. LOG: 160' S & 430' W FROM N 1/4 COR. SEC. 22

FINAL PROOF SURVEY UNDER

Application No. R-43740 Permit No. R-5024
43730 32687
43716 32677
 IN NAME OF

ERNEST M. COOKE

Surveyed MAY 26 1972, by R. R. MCKEN