


T.2S. R.4E. W.M.

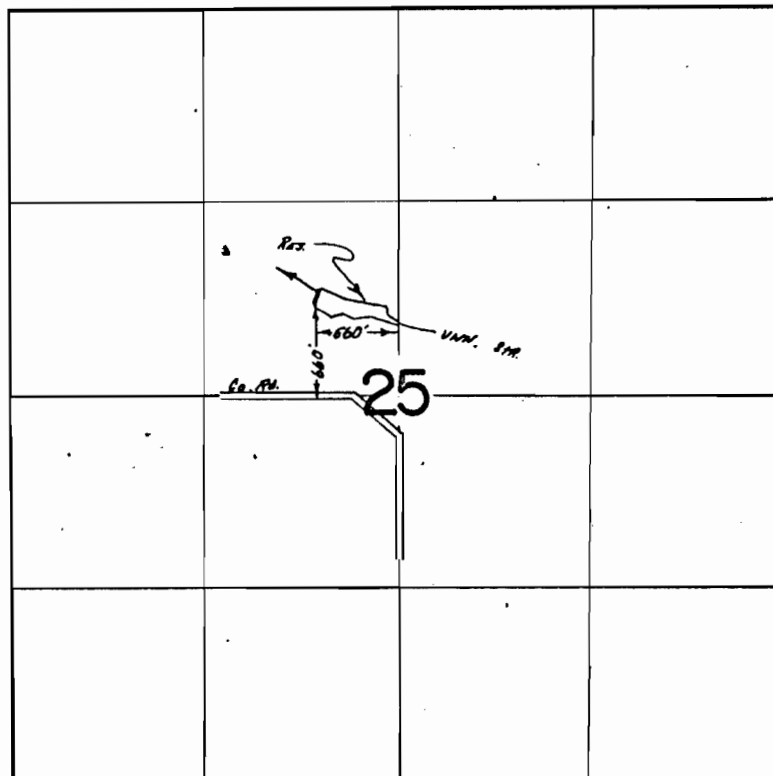

**FINAL PROOF SURVEY**  
UNDER

Application No. R-44846 Permit No. R-5305  
44847 32953  
IN NAME OF

C. L. KROMER

Surveyed MAY 25 1972, by R. G. MUCKER