


T.2S. R.4E. W.M.

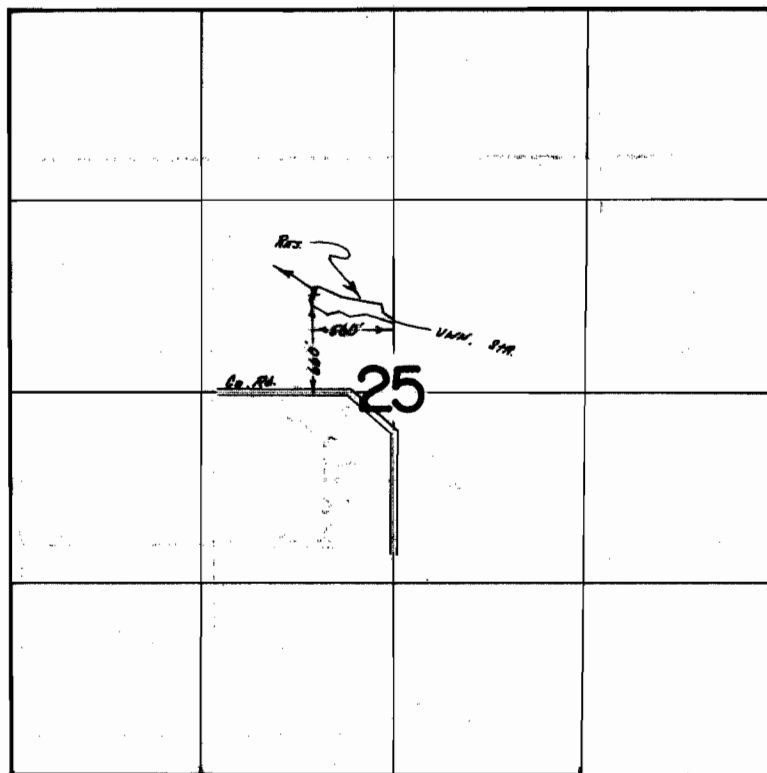

FINAL PROOF SURVEY
UNDER

Application No. R-48946 Permit No. R-5305
44947 32253
IN NAME OF

C. L. KROMER

Surveyed May 25 1922, by R. G. MURPHY