


T.4S.,R.1W-1E.,W.M.

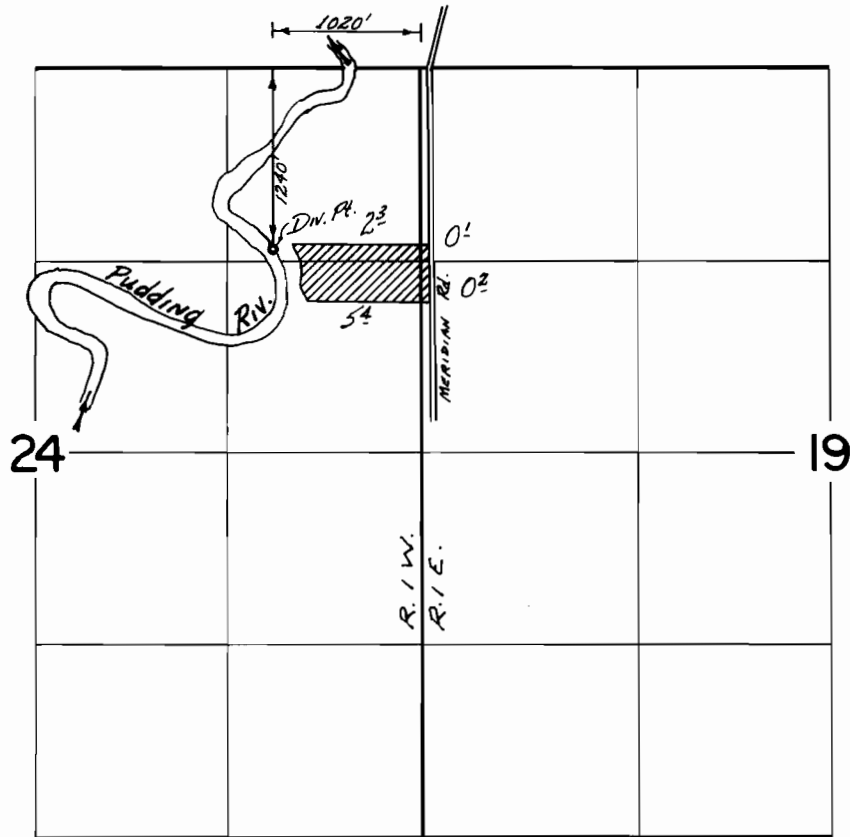

FINAL PROOF SURVEY
UNDER

Application No. 41830 Permit No. 31307
IN NAME OF

CARL DAVIS PEOPLES

Surveyed July 30 1973, by D. NORBY