


T.4S., R.1W.-1E., W.M.

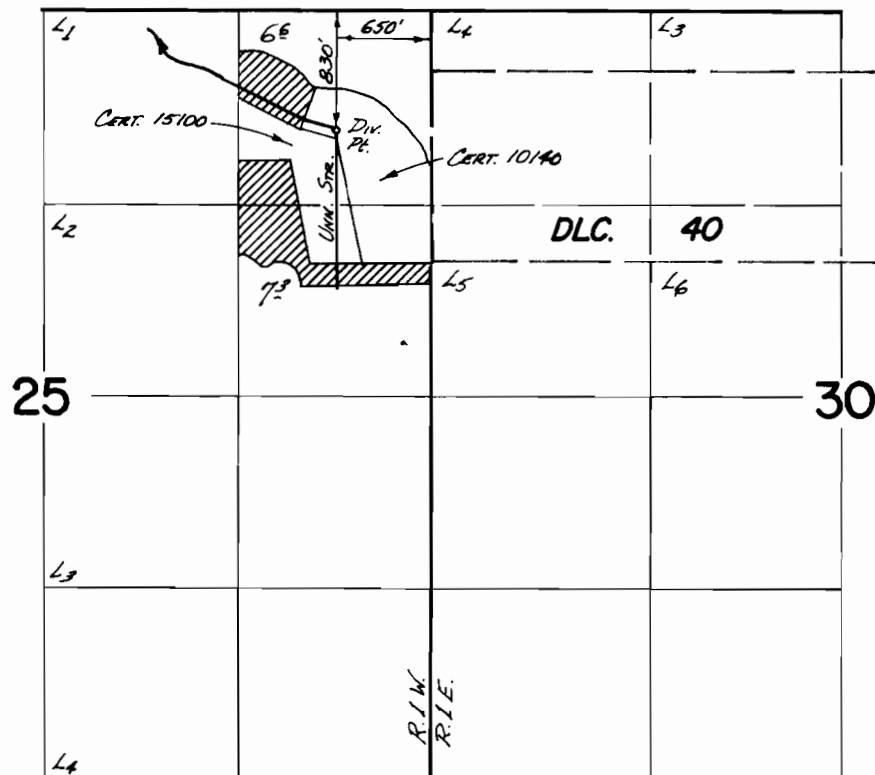

FINAL PROOF SURVEY
UNDER

Application No. 42387 Permit No. 31665
IN NAME OF

ART & ARLENE HAUSER

Surveyed July 30 1973, by D. NORBY