


T.2S. R.3E. W.M.

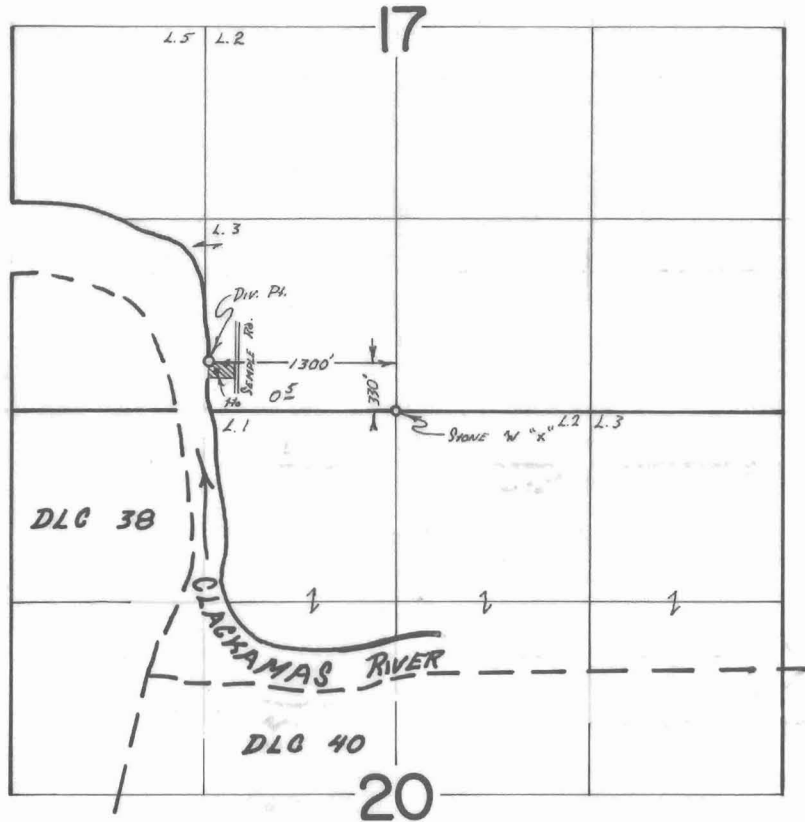

FINAL PROOF SURVEY
UNDER

Application No. 16424 Permit No. 34590
IN NAME OF

KARL F. KANNENBERG

Surveyed SEP 14 1972, by R. G. MUCKEN