


T.3S., R.2E., W.M.

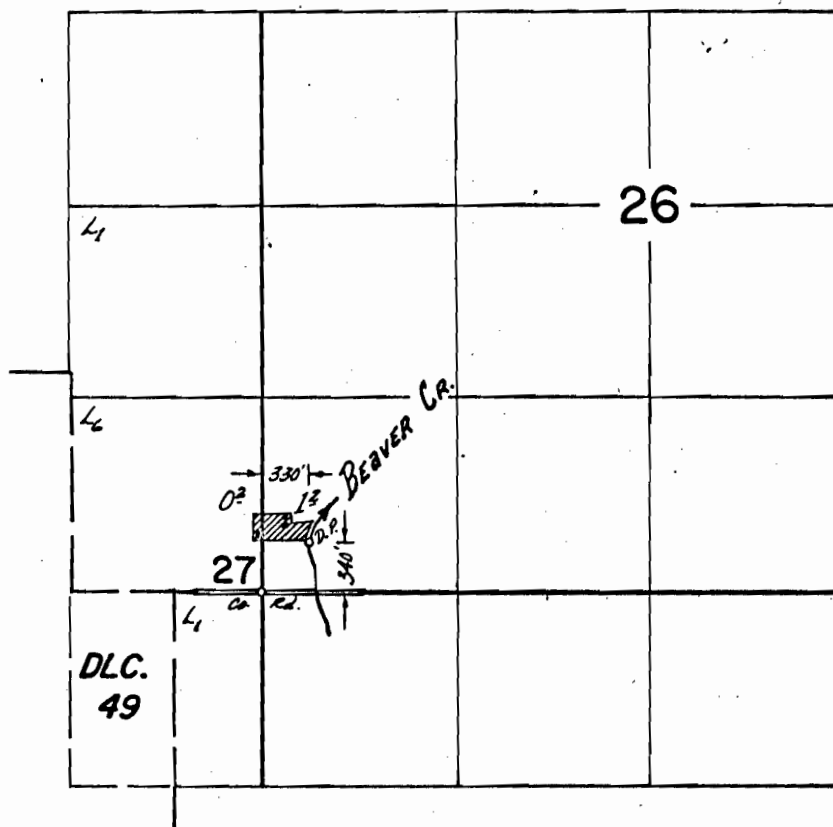

FINAL PROOF SURVEY
UNDER

Application No. 48908 Permit No. 36635
IN NAME OF

CECIL O. MCKAY

Surveyed Aug. 3 1973, by D. NORBY