


T.38S.,R.4W.,W.M.

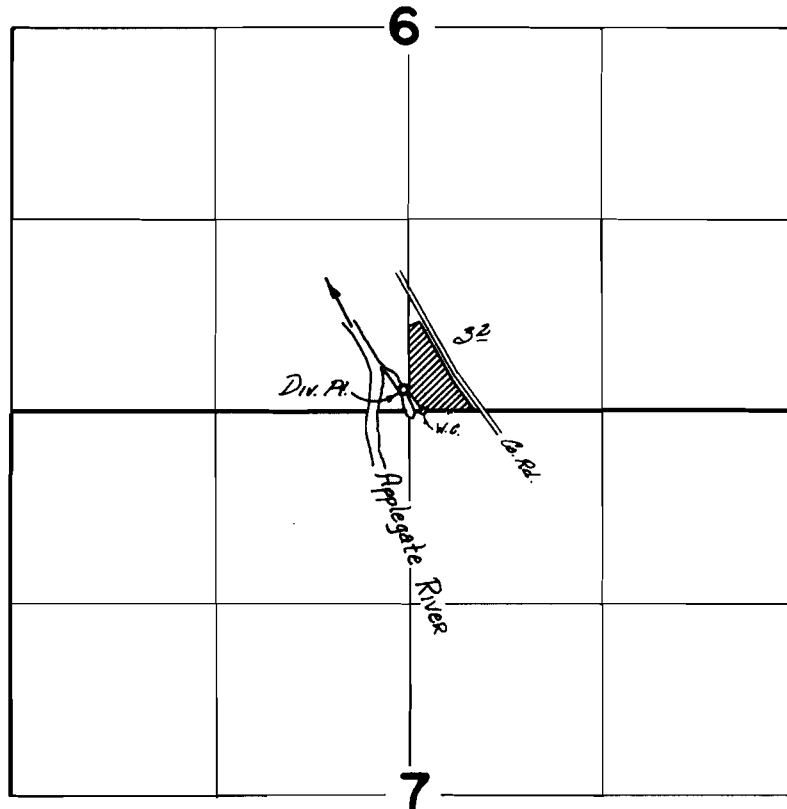

Dir. Pt. loc: 130' N. of 40' W. from S 1/4 cor. Sec. 6.

FINAL PROOF SURVEY
UNDER

Application No. 43877 Permit No. 32786
IN NAME OF

RALPH D. TIPTON

Surveyed Oct. 9 1973, by D. NORBY