


T.36S.R.7W.W.M.

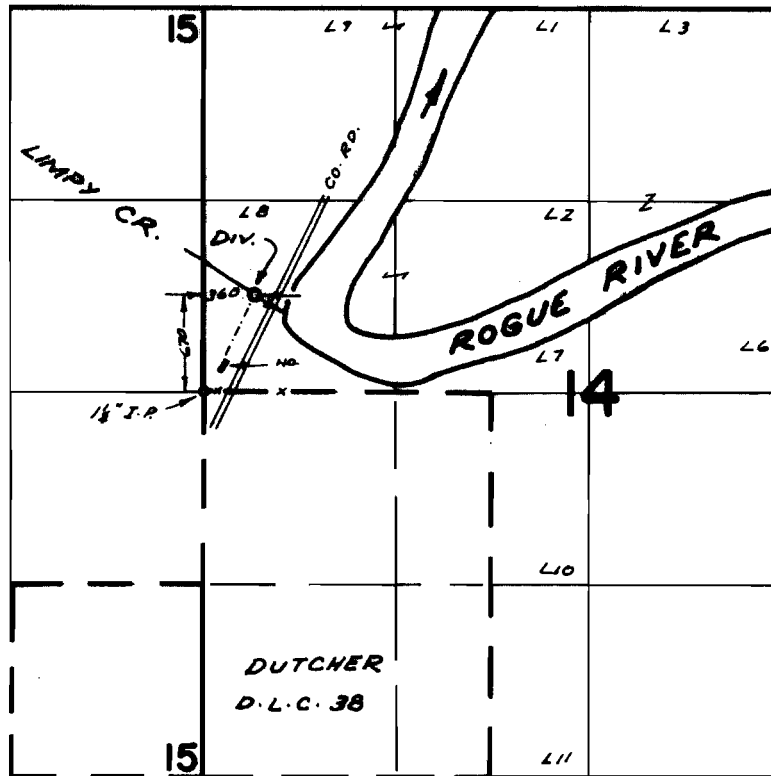

FINAL PROOF SURVEY UNDER

Application No. 44061 Permit No. 32924
IN NAME OF

FRANK E. KEESEE

Surveyed APR. 19, 1972, by R. MUCKEN