


31991
40545

T.40S., R.8E., W.M.

Klamath River

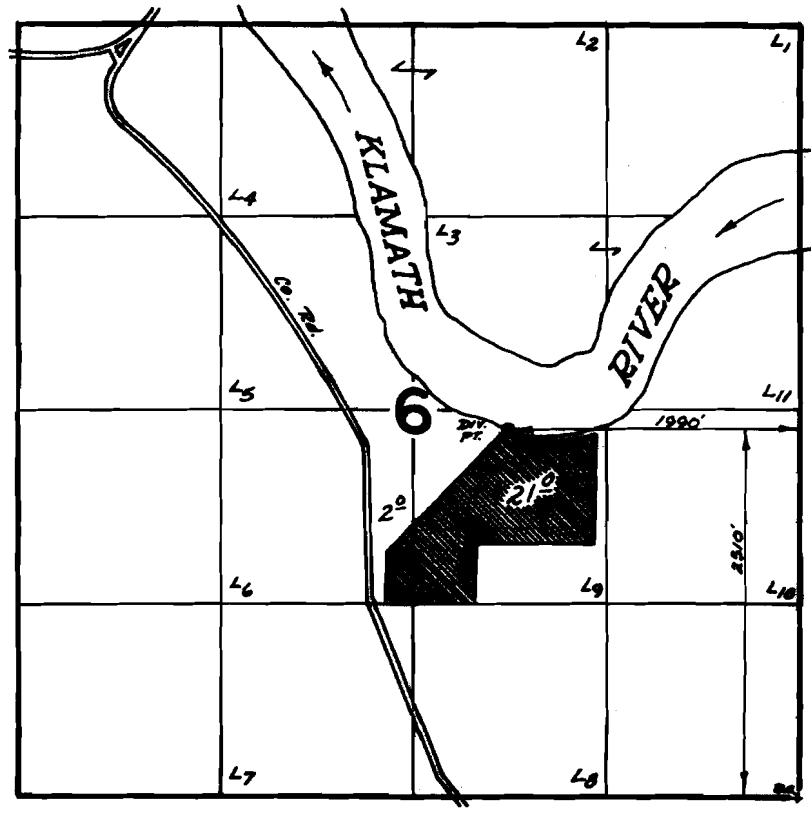

FINAL PROOF SURVEY UNDER

Application No. 42790 Permit No. 3/991
IN NAME OF

RICHARD & JO ANNE BERG

Surveyed Oct. 19 1972, by D. Norby