


T.40S. R.19E. W.M.

R-5763

40544

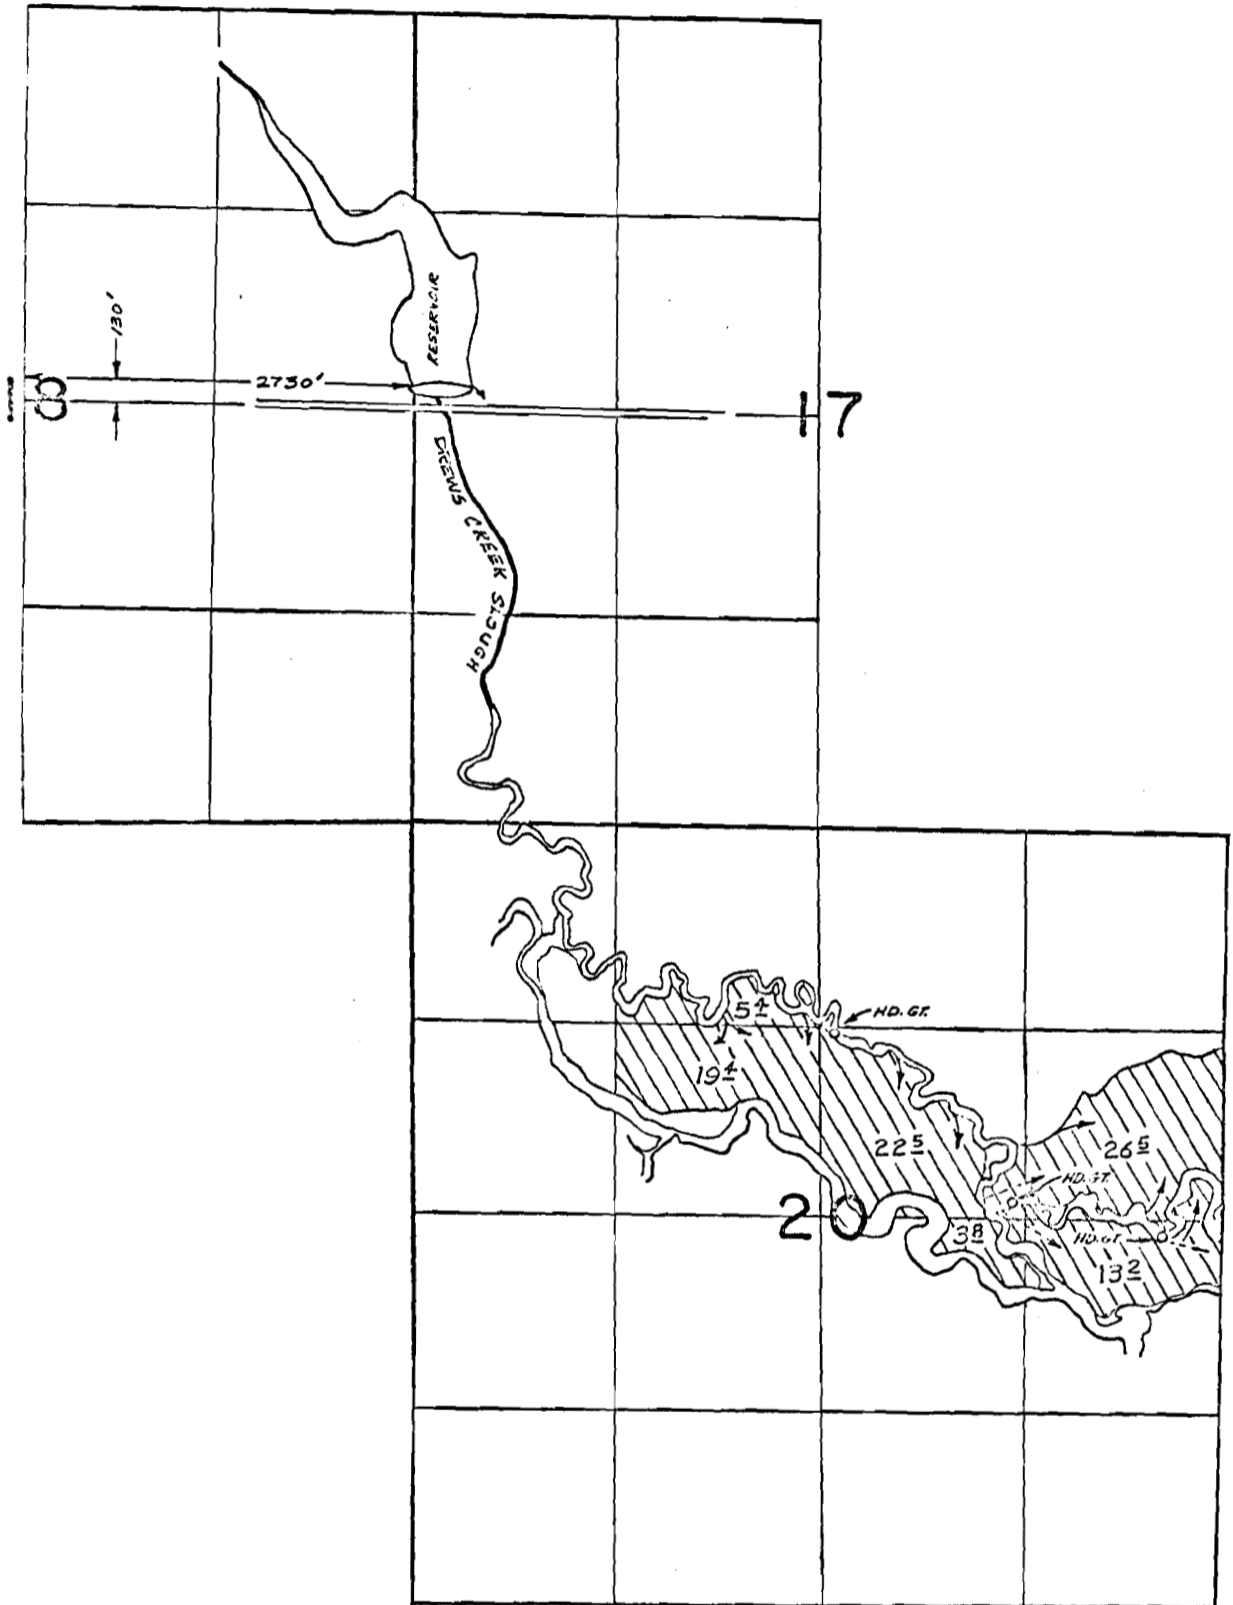

FINAL PROOF SURVEY

UNDER  
47725

35749


Application No. R-47724 Permit No. R-5763

IN NAME OF

.....RALPH T. RENNER.....

Surveyed AUGUST 28 1973, by R. MUCKEN

T.40S. R.19E. W.M.

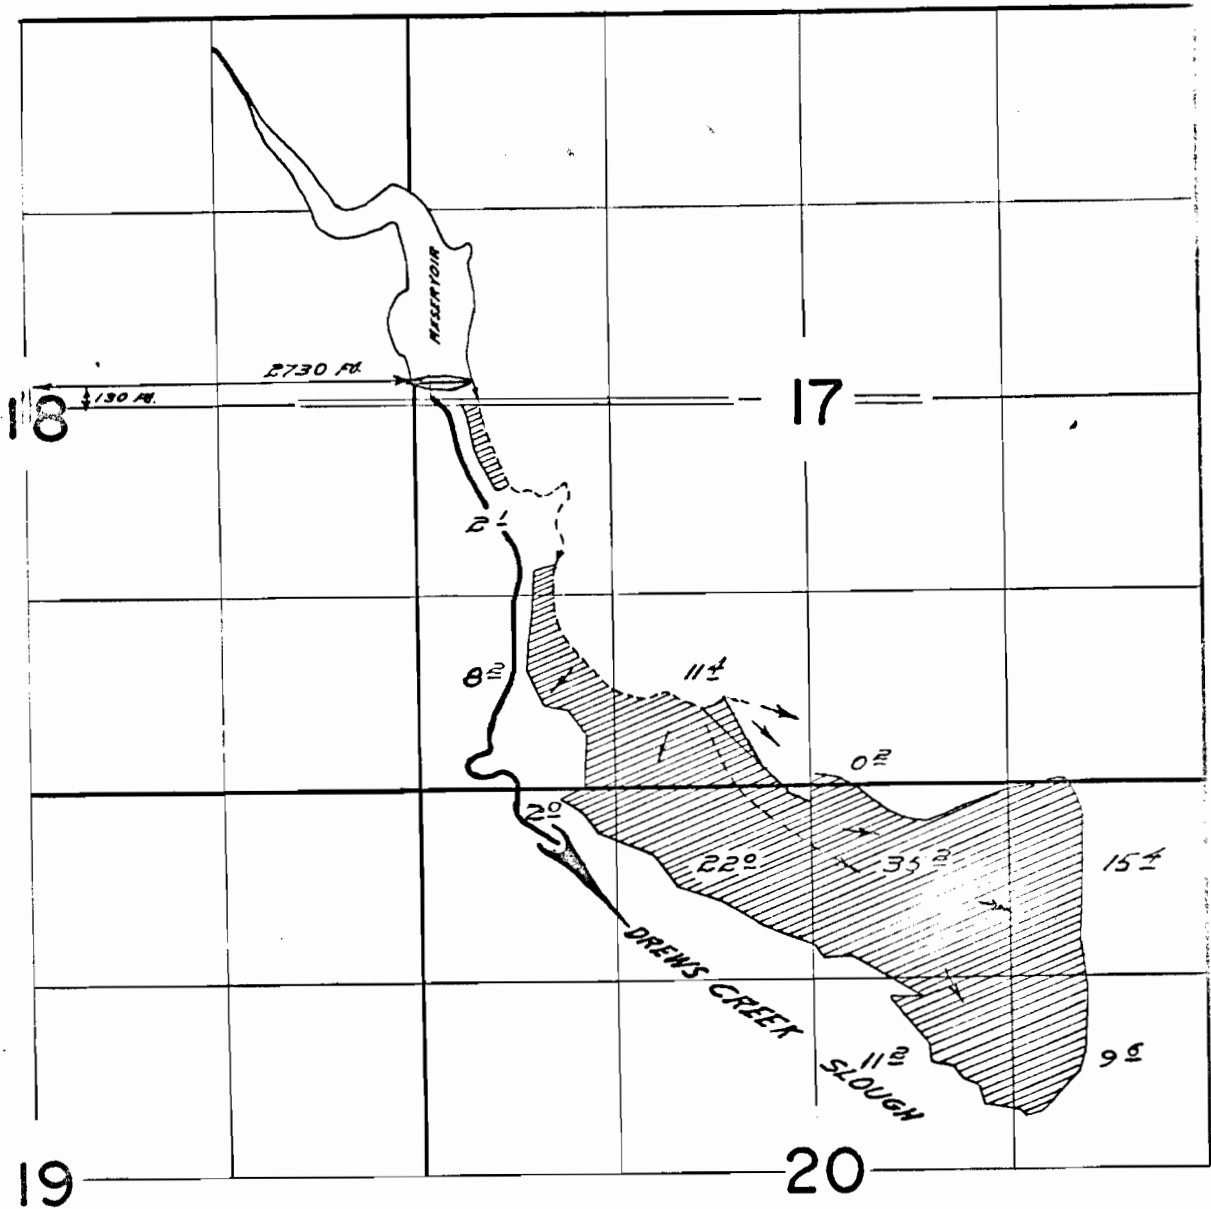

FINAL PROOF SURVEY  
UNDER

Application No. 34749.. Permit No. 27782  
IN NAME OF

*RALPH T. RENNER*

JULY 30, 1968

Surveyed Aug. 30 1967, by *W. D. Ruppel*