


T.40S. R.19E. W.M.

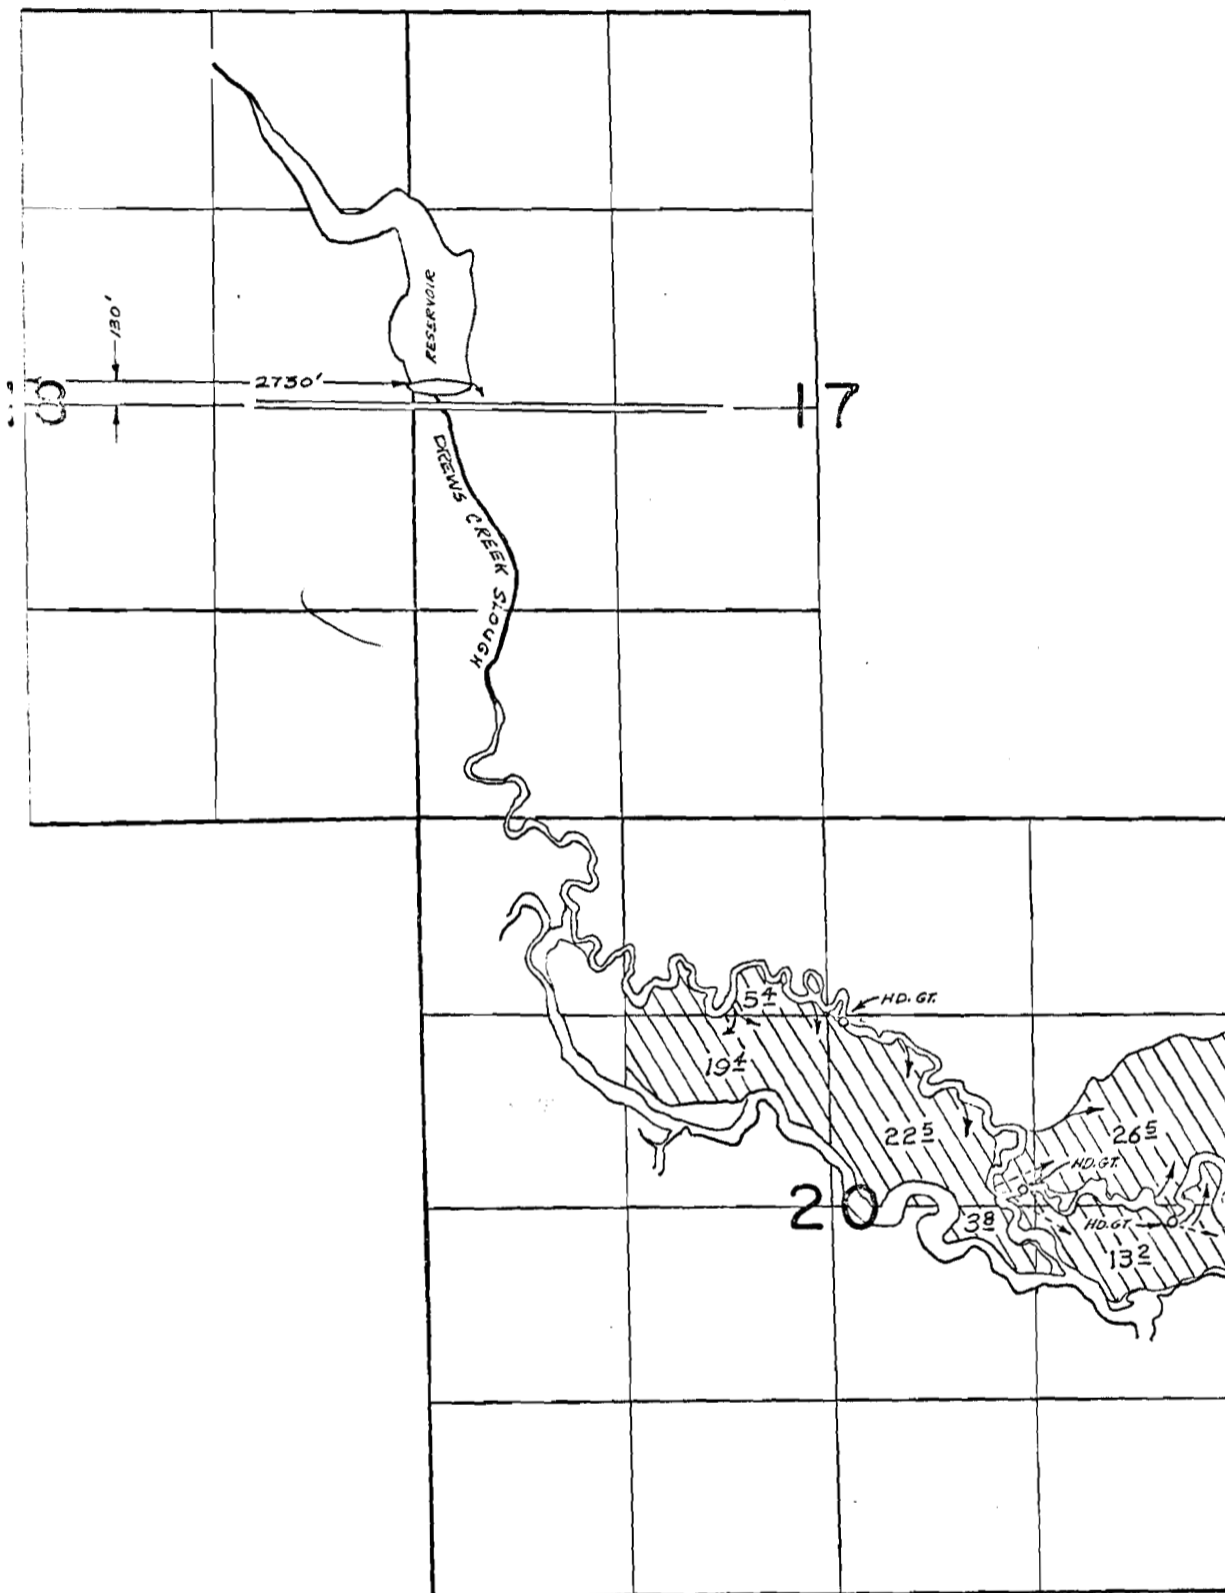

FINAL PROOF SURVEY

UNDER

47725

35749

Application No. ~~R-47724~~ Permit No. ~~R-5763~~

IN NAME OF

RALPH T. RENNER

Surveyed AUGUST 28 1973, by R. MUCKEN