


T. 6 & 7 S. R. 10 W. W. M.

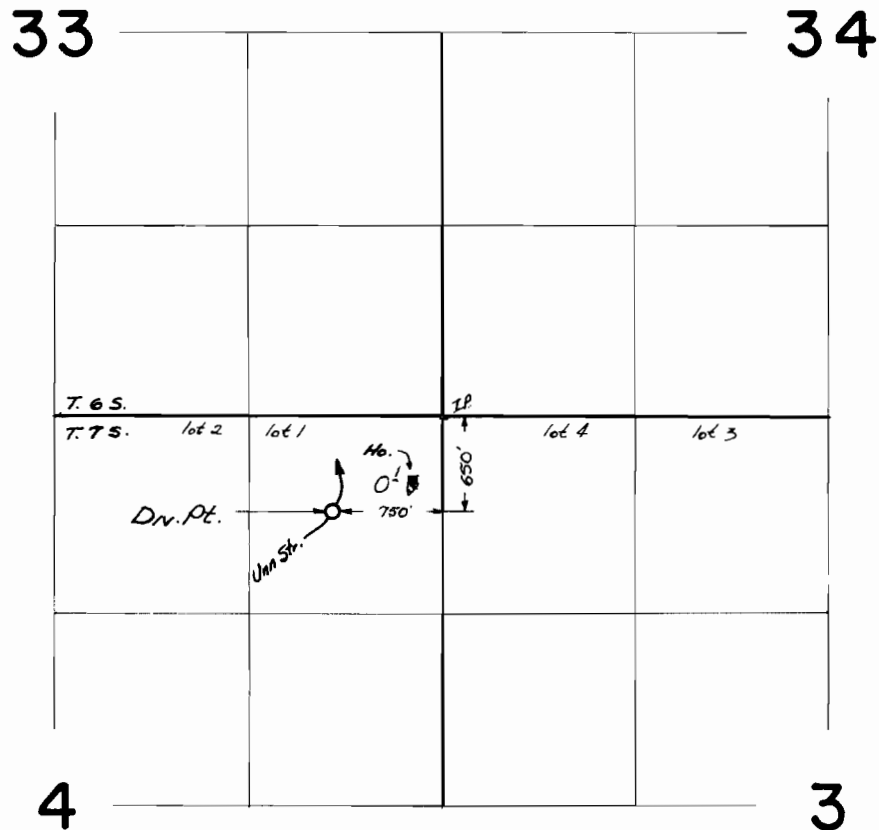

FINAL PROOF SURVEY
UNDER

Application No. 44971 Permit No. 33614
IN NAME OF

EDNA WENDOLIN

Surveyed 3 OCT 1969, by L.E. GOULD