


# T.9S.R.IW.W.M.

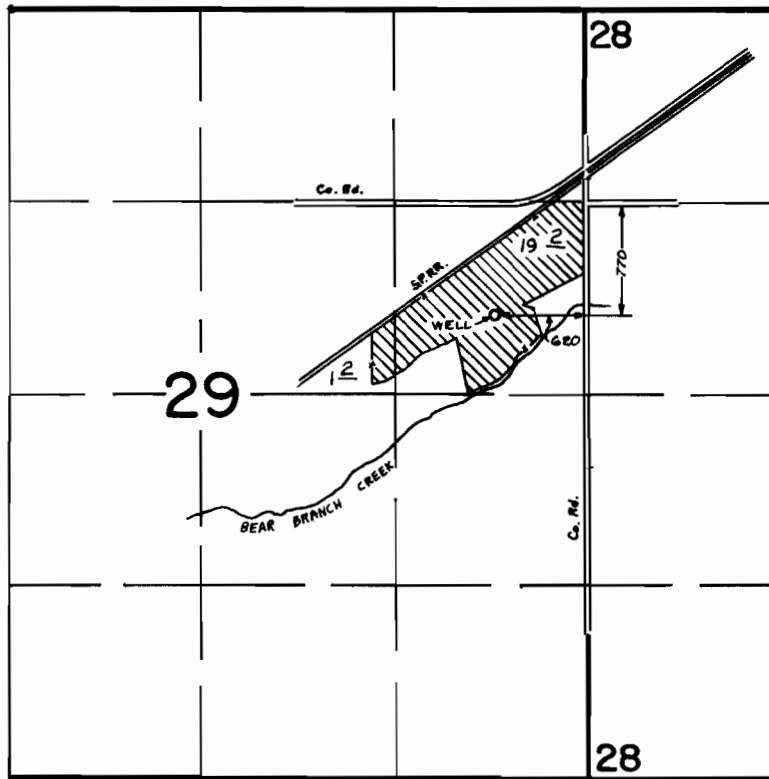

## FINAL PROOF SURVEY UNDER

Application No. G 4082 Permit No. G 3836  
IN NAME OF

LEONARD LAMBRECHT

Surveyed JUNE 9 1972, by D. BUELL