


T. 11 S. R. 3 W. W.M.

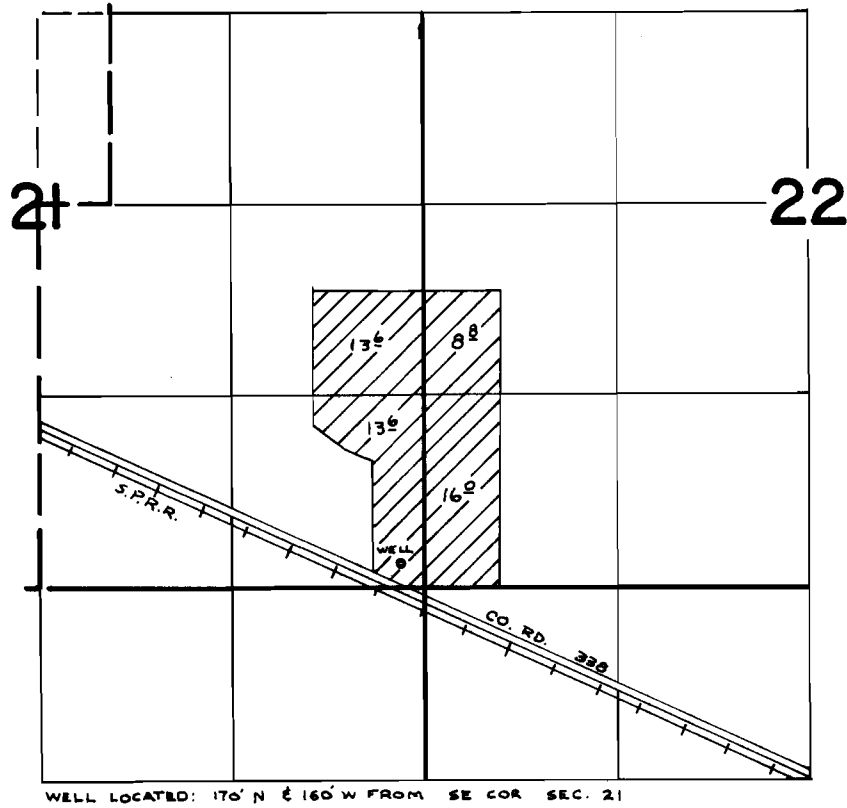

FINAL PROOF SURVEY
UNDER

Application No. G-4241 Permit No. G-4003
IN NAME OF

NORMAN AND MILDRED STECKLEY

Surveyed Sept. 7, 1972, by D. Norby