


T. 11S. R. 3W. W.M.

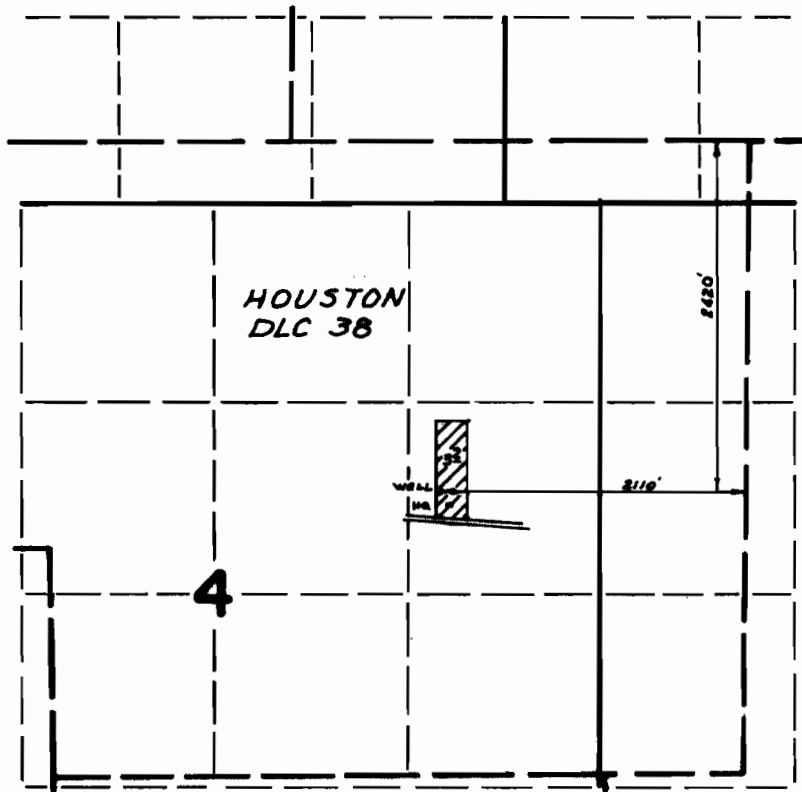

FINAL PROOF SURVEY
UNDER

Application No. G-4413 Permit No. G-4159
IN NAME OF

V. V. & BLANCHE A. HARVEY

Surveyed SEPT. 7, 1972, by D. Norby