


T. 12 S. R. 2 W. W. M.

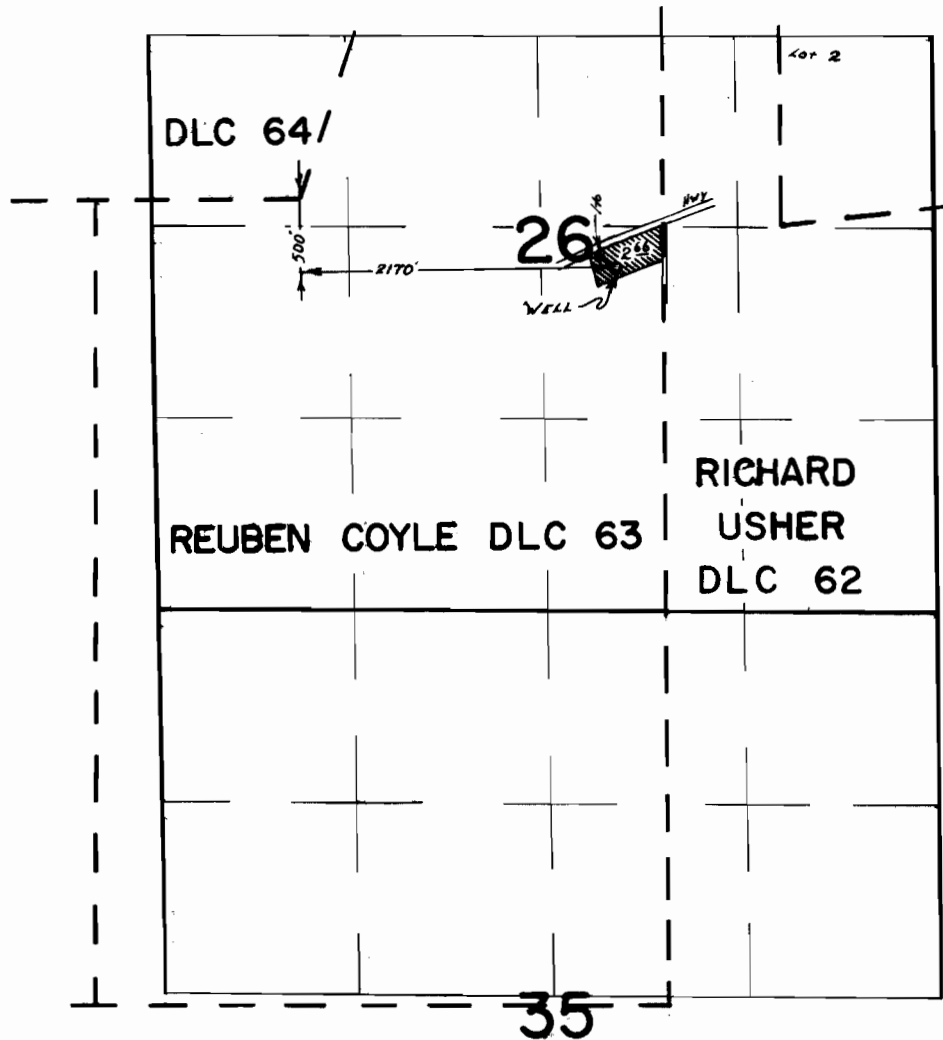

FINAL PROOF SURVEY
UNDER

Application No. G-1564 Permit No. G-1288
IN NAME OF

JOSEPH M. & NINA V. CRENSHAW

Surveyed SEP. 7 1972, by R. G. MCKEN