


T. 12 S. R. 2 W. W.M.

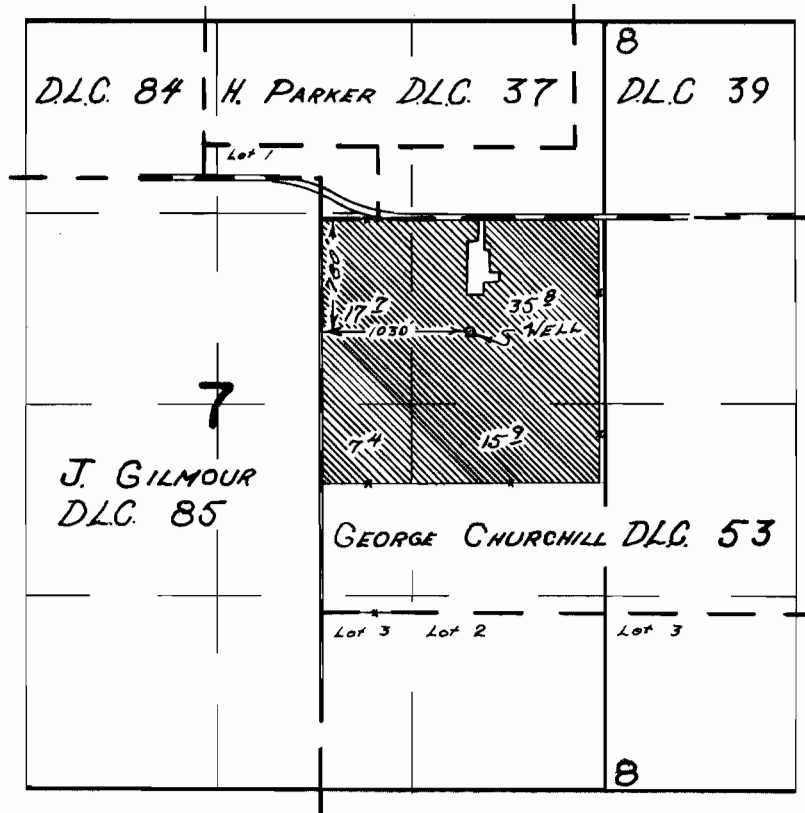

FINAL PROOF SURVEY
UNDER

Application No. G-4245 Permit No. G-4464
IN NAME OF

CLARENCE C. OPEL

Surveyed SEP 6 1972, by R. G. MUCKEN