


T.12S., R.1E., W.M.

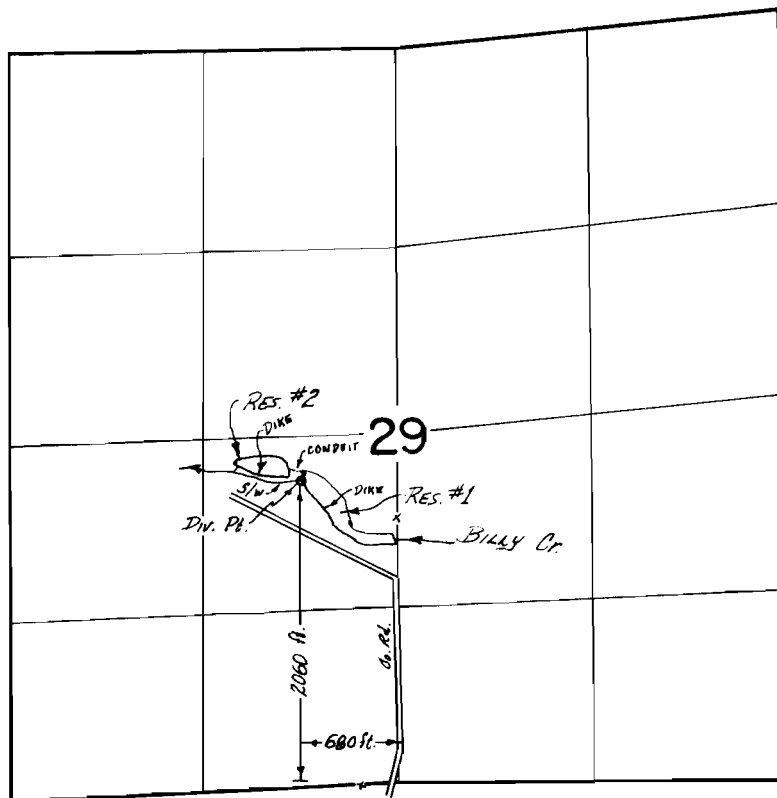

FINAL PROOF SURVEY
UNDER

R-47529 R-5725
Application No. 47530 Permit No. 35594
IN NAME OF

A. V. GILBERT

Surveyed Sept. 7 19 72, by R. MUCKEN