


T.I.S.R.I.W.W.M.

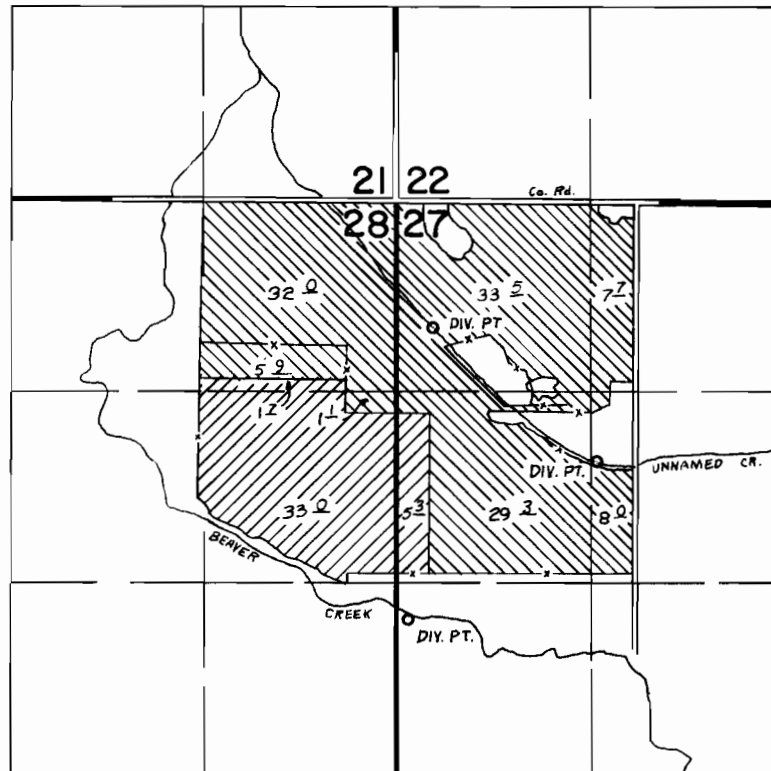

UNNAMED CREEK — DIV. PT. 860 FT. S 250 FT. E.
DIV. PT. 1775 FT. S 1365 FT. E.
BEAVER CREEK — DIV. PT. 2875 FT. S 75 FT. E
ALL FROM NW COR SEC. 27

FINAL PROOF SURVEY
UNDER

Application No. 42685 Permit No. 32263
IN NAME OF

WAYLAND G. & FAY L. SMALL

Surveyed JUNE 6, 8 1972, by D. BUELL