


T.12S.R.IW.W.M.

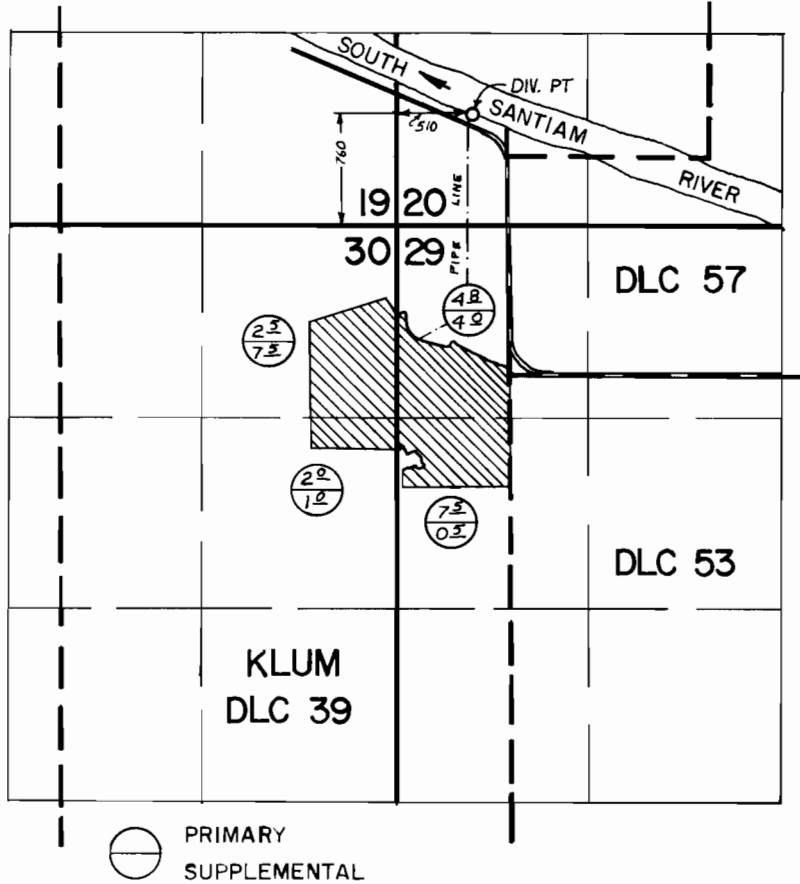

FINAL PROOF SURVEY UNDER

Application No. 43371 Permit No. 32415
IN NAME OF

CLARENCE A. TEMPLE & AUDREY TEMPLE

Surveyed MAY 23 1972, by D. BUELL