


T.IOS., R.I.E., W.M.

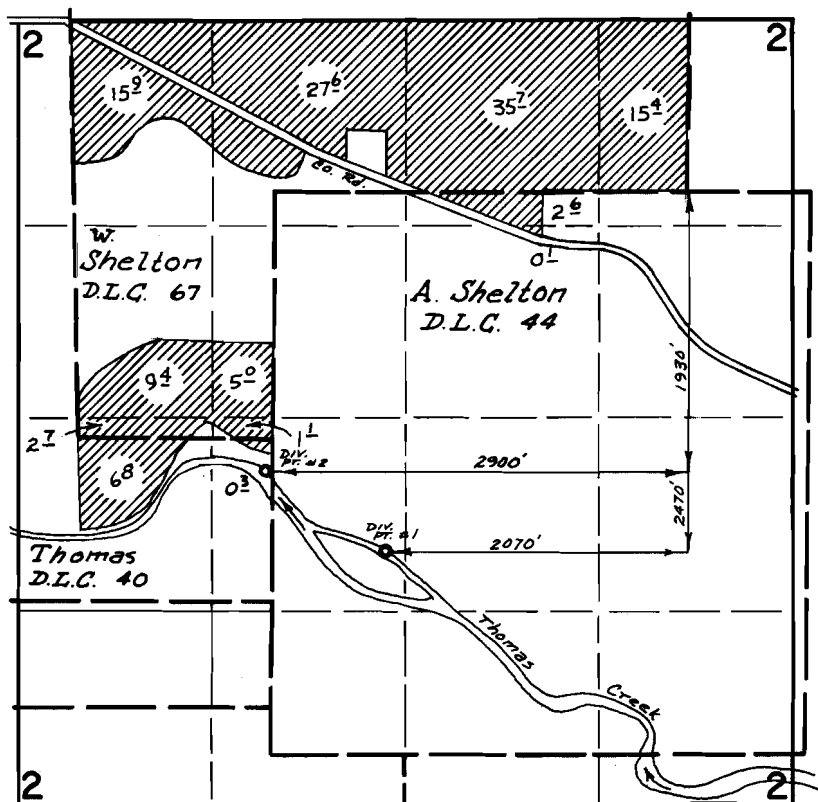

FINAL PROOF SURVEY
UNDER

Application No. 43443 Permit No. 32427
IN NAME OF

LULAY FARMS, INC.

Surveyed Aug. 31 1972, by D. Norby