


# T. 12S. R. 1W. W.M

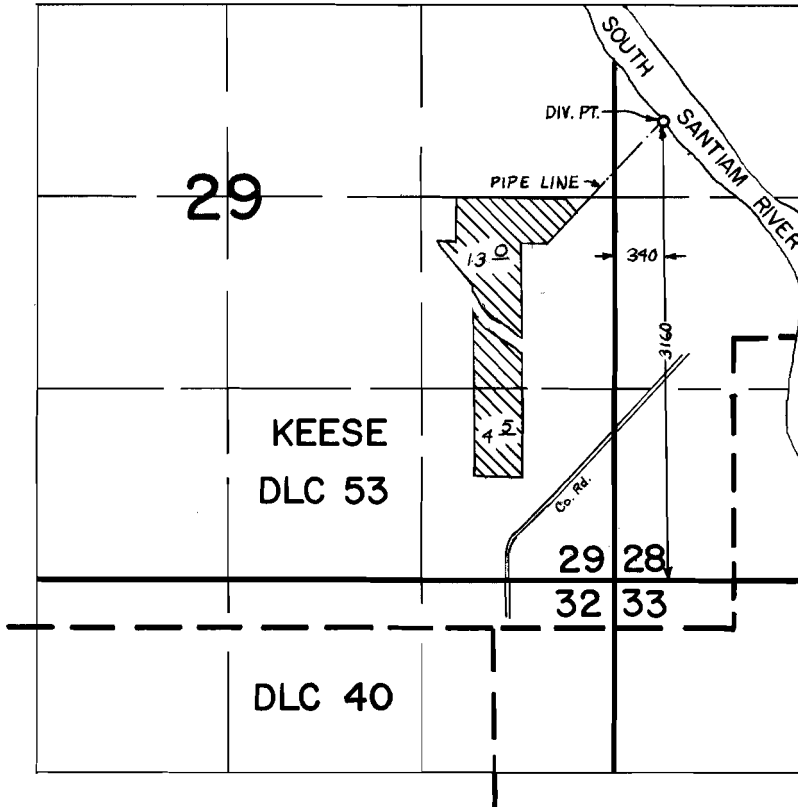

## FINAL PROOF SURVEY UNDER

Application No. 44022 Permit No. 32988  
IN NAME OF

JOHN T. & ANNA LOUISE VAWTER

Surveyed MAY 23 1972, by D. BUELL