




# T. 10S. R. 2W. W.M.

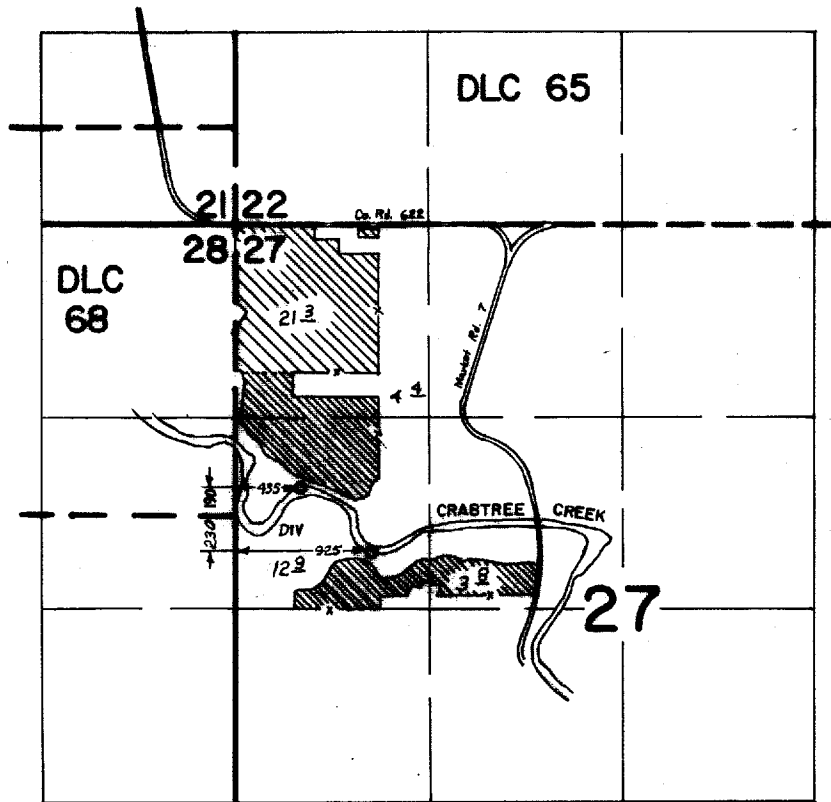

-  AUGUST 20, 1968
-  MARCH 7, 1969

## FINAL PROOF SURVEY UNDER

Application No. 45314 Permit No. 33785  
IN NAME OF

W. J. & M. J. KELLY

Surveyed JUNE 7 1972, by D. BUELL