


T. 14 S. R. 2 E. W. M.

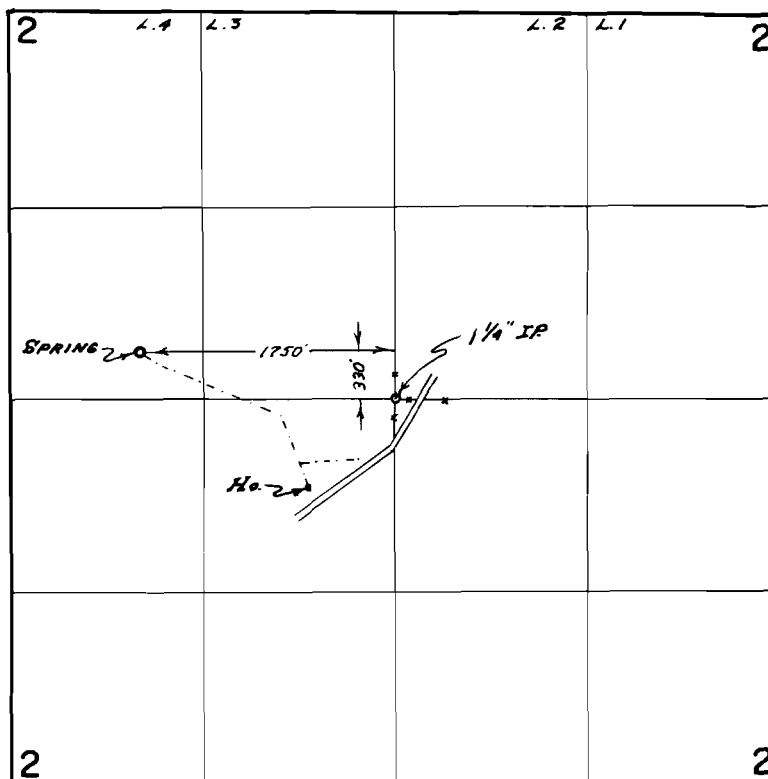

FINAL PROOF SURVEY
UNDER

Application No. 15505 Permit No. 33962
IN NAME OF

LEIGHTON J. & HAZEL L. HARRIS

Surveyed SEP 8 1972, by R. G. McV. G. S. M.