


T.10S. R.3W. W.M.

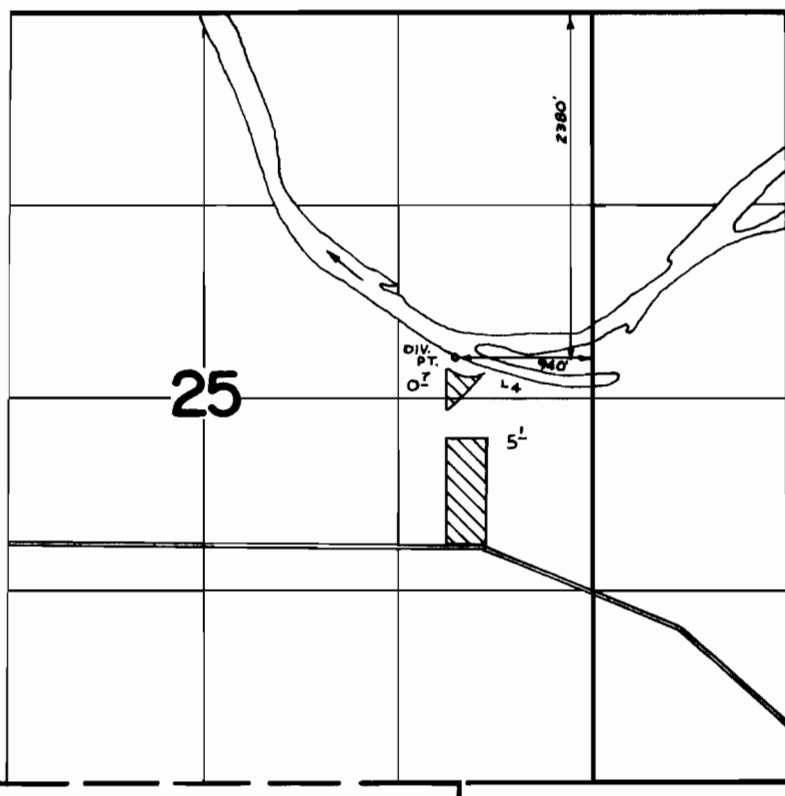

FINAL PROOF SURVEY
UNDER

Application No. 46073 Permit No. 34427
IN NAME OF

DELMAR & DOLORES KENNEL

Surveyed SEPT. 6, 1972, by D. Norby