


T. 14 S. R. 1 E. W. M.

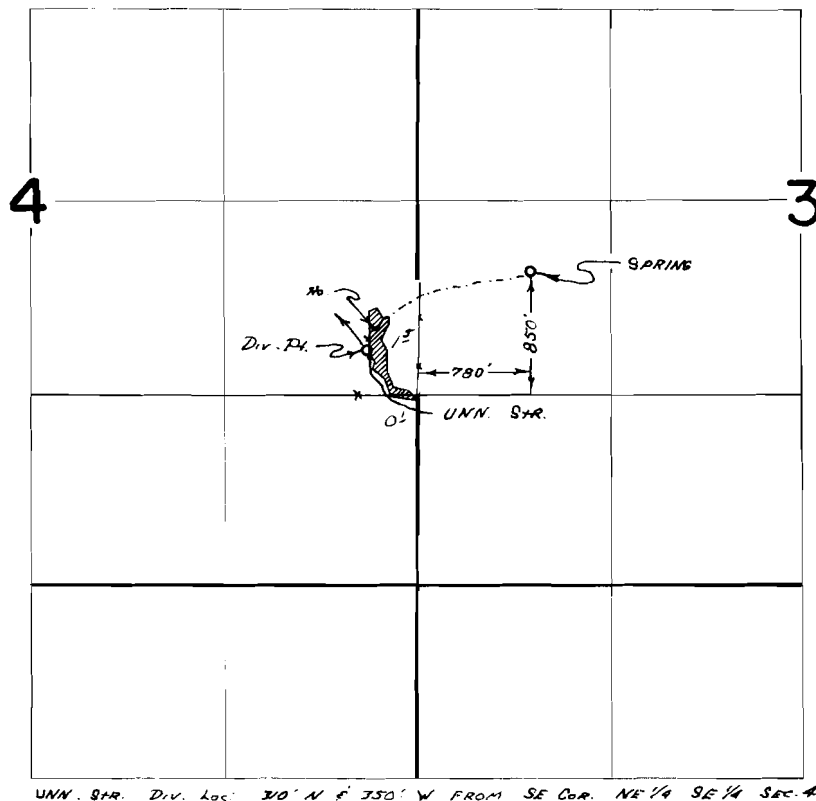


FINAL PROOF SURVEY
UNDER

Application No. 16,370 Permit No. 34495
IN NAME OF

STANLEY D. WALTERS

Surveyed SEP. 8 1972, by R. G. MUCKEN