


T. 12S. R. 1W. W.M.

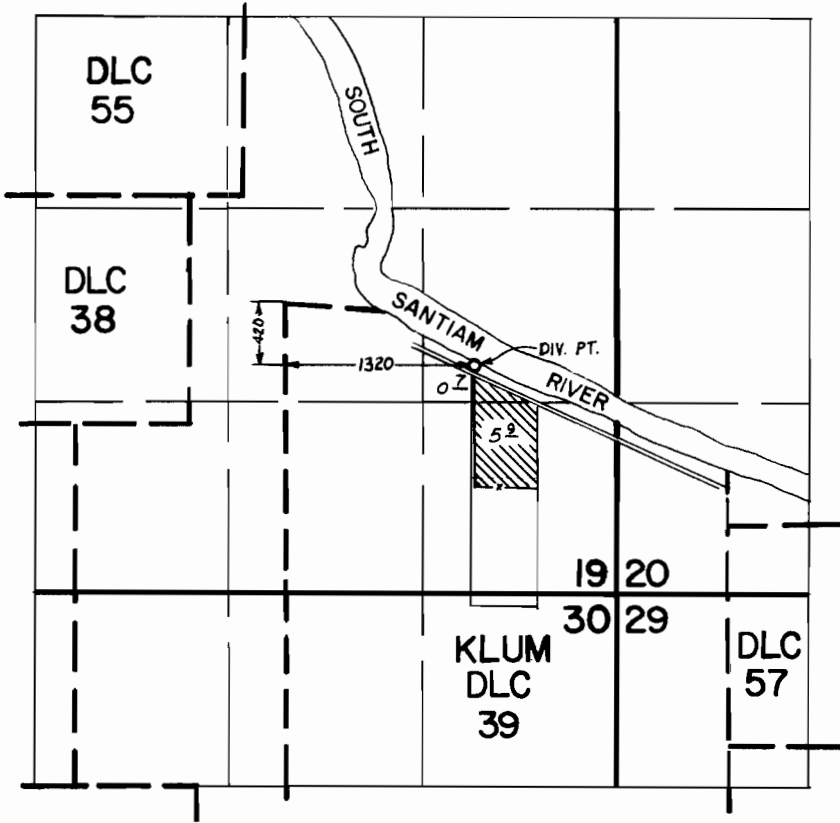

FINAL PROOF SURVEY UNDER

Application No. 46702 Permit No. 34899
IN NAME OF

WAYNE A. & ELIZABETH M. SAUNDERS

Surveyed MAY 22 1972, by D. BUELL