


# T.4S.R.2W.W.M.

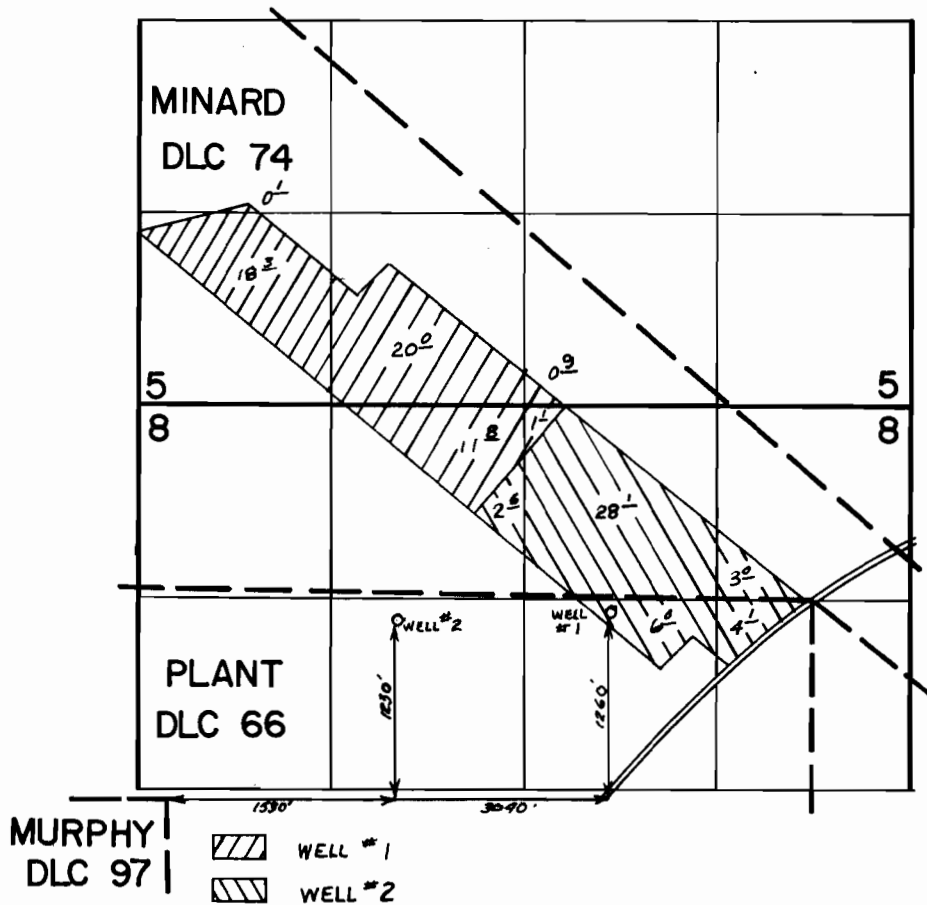

## FINAL PROOF SURVEY UNDER

Transfer No. 2467  
 Application No. G-3427 Permit No. G-3213  
 IN NAME OF  
 NELSON G. & HOWARD O. TRIBBETT  
 (dba Tribbett & Son)

Surveyed Oct. 3 1972, by D. Norby