


T.5 S. R.2 W., W.M.

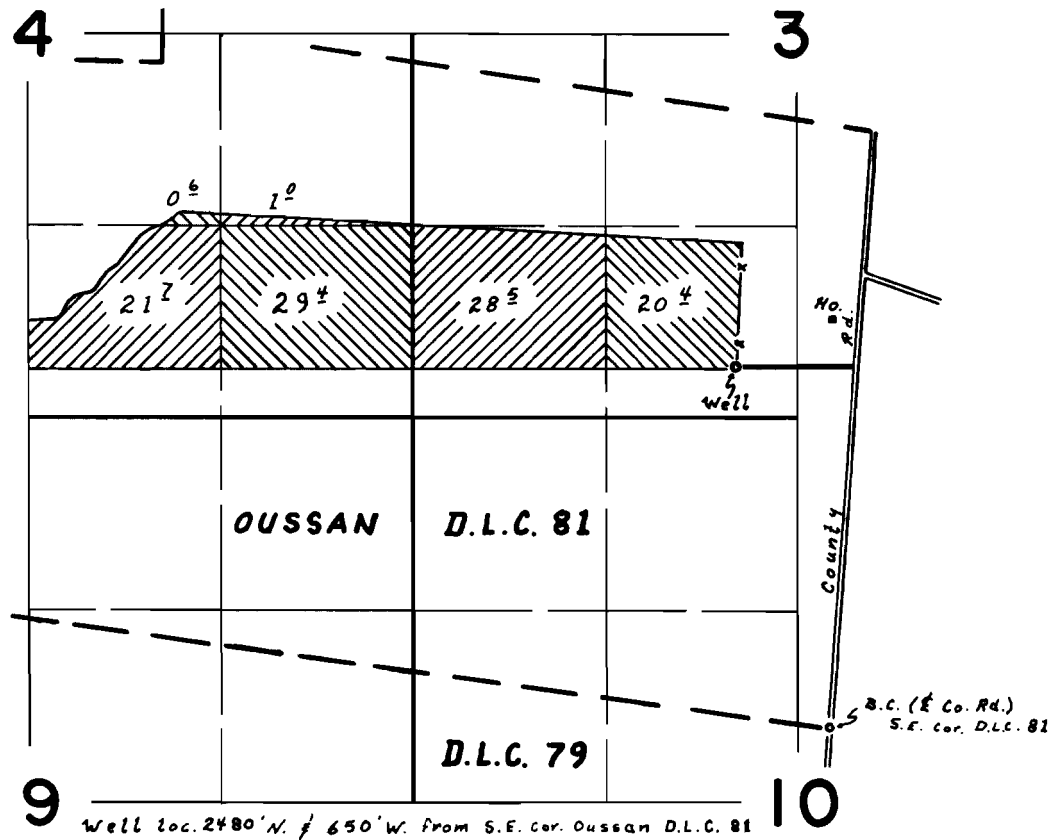

**FINAL PROOF SURVEY**  
UNDER

Application No. G-3559 Permit No. G-3357  
IN NAME OF

*HOCKETT FARMS INC.*

Surveyed 13 OCT. 1972 by D. O'Reilly