


T. 6 S. R. 1 E. W. 1 M.

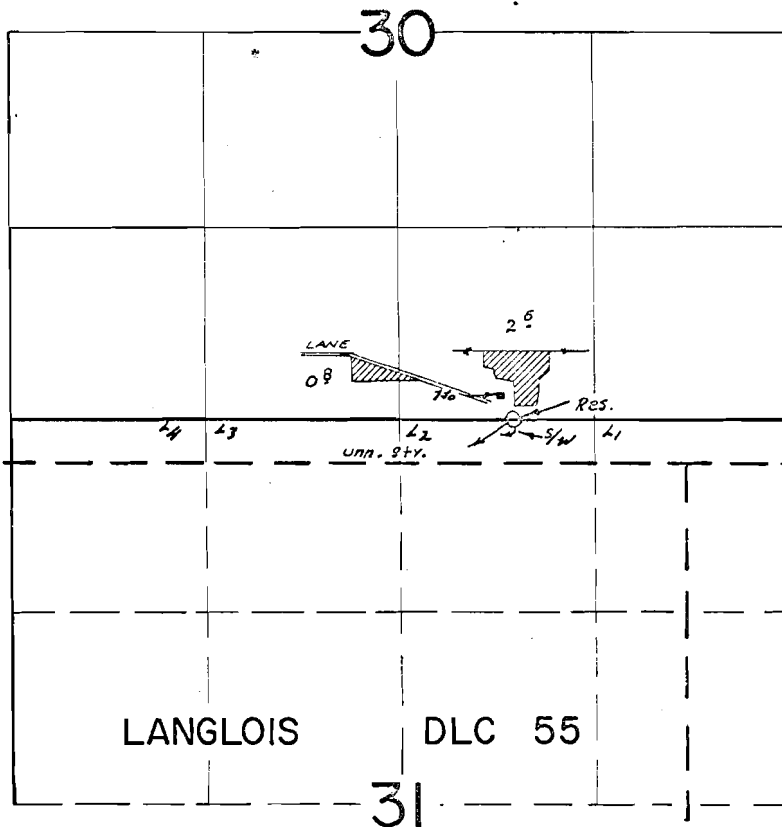

Res. Loc. 20' S & 3370' E FROM NW Cor. Sec. 91

FINAL PROOF SURVEY
UNDER

Application No. ^{R-41124} 41125 Permit No. ^{R-4619} 30659
IN NAME OF

JOSEPH GREGONIS

Surveyed June 6, 1973, by R. G. Mucken