


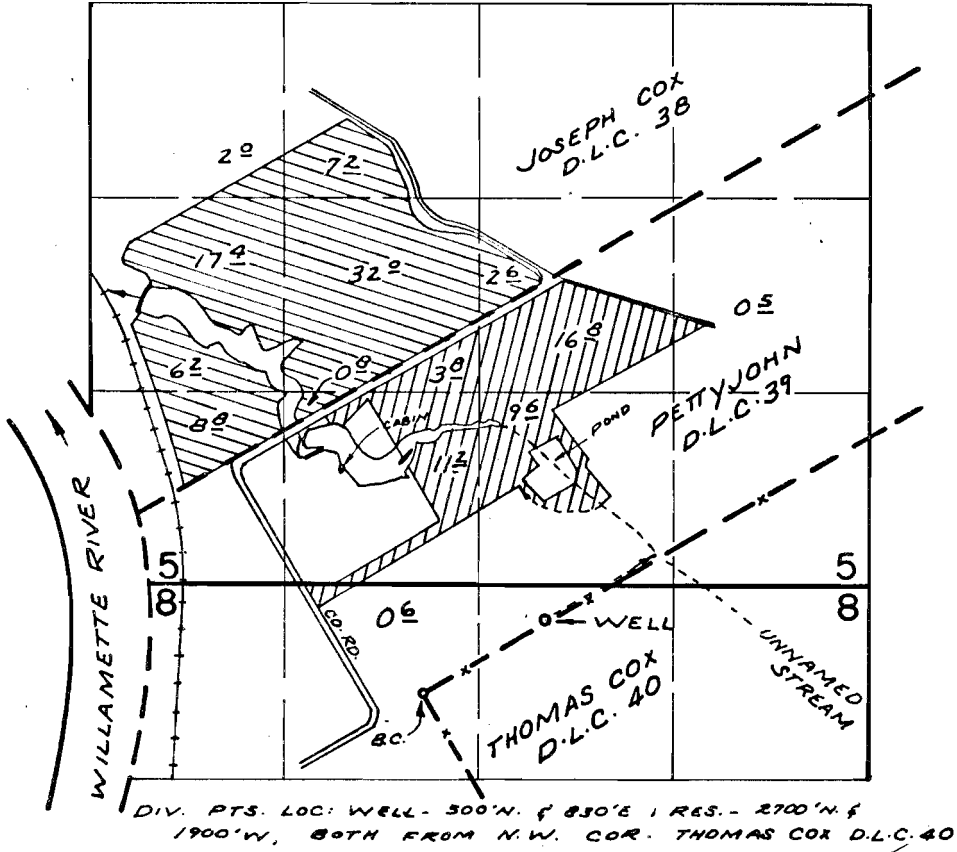


# T.9S.R.3 W.W.M.



## FINAL PROOF SURVEY UNDER

|                        |                   |   |
|------------------------|-------------------|---|
| 44315                  | 33093             |  |
| R-41977                | R-4697            |   |
| 41978                  | 31108             |  |
| Application No. G-3417 | Permit No. G-3089 |  |

IN NAME OF

..... JAMES L. PAYNE .....

Surveyed JULY 25, 1968, by V. GARNER  
OCT 27 1972 R. MUCKEN