


T.9S.R.3W.W.M.

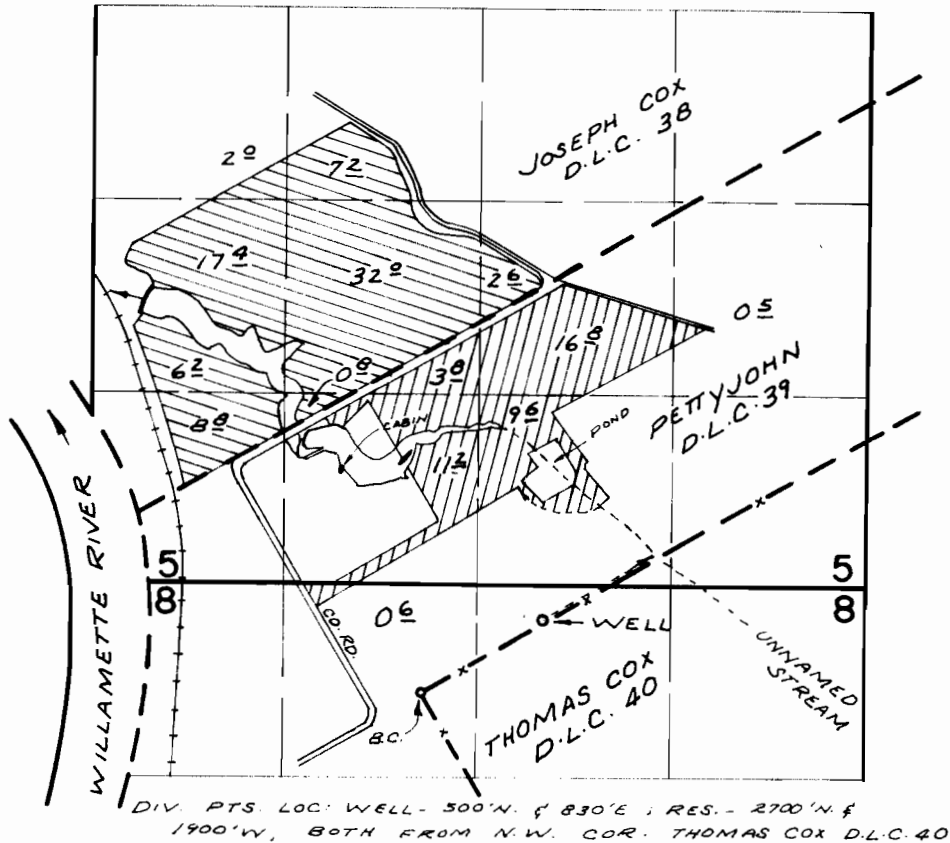

FINAL PROOF SURVEY

UNDER

44315
R-41977
41978

33093
R-4697
31108

Application No. G-3417 Permit No. G-3089

IN NAME OF

JAMES L. PAYNE

Surveyed July 25, 1968, by V. GARNER
OCT 27 1972 R. MUCKEN