# T.4 S., R.2W., W.M.

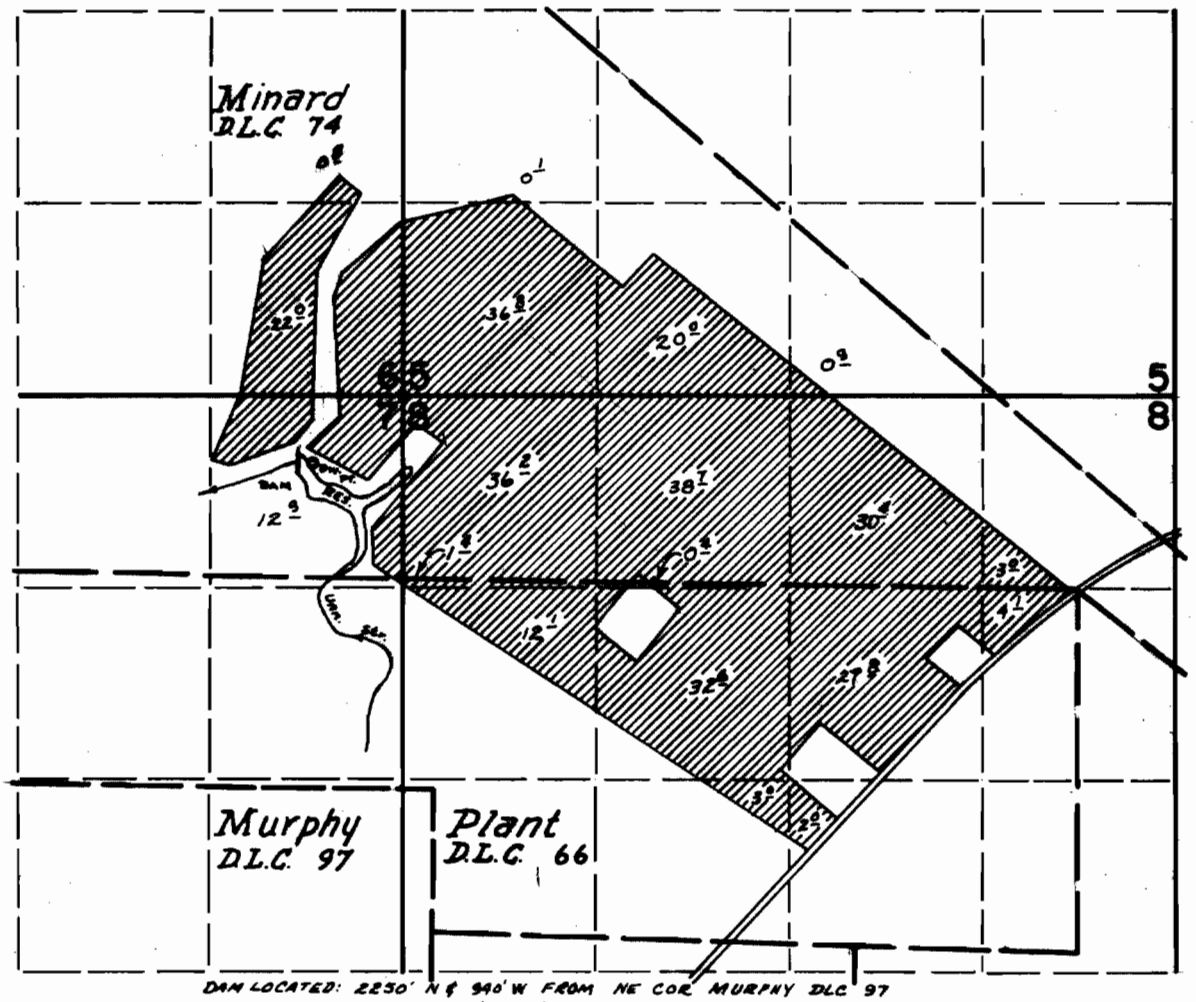


DAM LOCATED: 2250' N & 940' W FROM NE COR. MURPHY DLC 97
DIV. PT. LOCATED: 2250' N & 820' W FROM NE COR. MURPHY DLC 97

## FINAL PROOF SURVEY

UNDER

R-43600 R-4928
43601 32251
R-44845 R-5102

Application No. 44846 Permit No. 32999

IN NAME OF

NELSON C. & HOWARD O. TRIBBETT
(dba: Tribbett & Son)

Surveyed Oct. 3 1972, by D. Norby

DFN-BD-121, DFN-GLL-128, 1968-J