T.9S.R.3W.W.M.

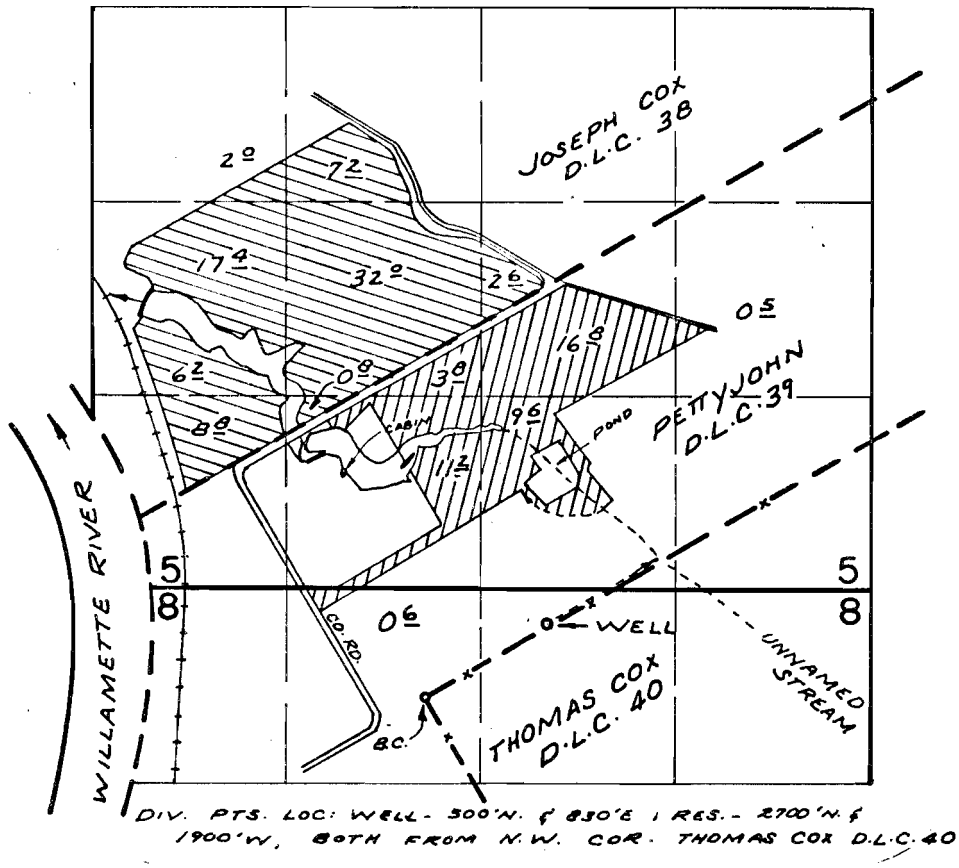

FINAL PROOF SURVEY

UNDER

44315 — 33093
R-41977 — R-4697
41978 — 31108

Application No. G-3417 Permit No. G-3089

IN NAME OF

JAMES L. PAYNE

Surveyed JULY 25, 1968, by V. GARNER
OCT 27 1972 R. MUCKEN