


T.5S. R.1W. W.M.

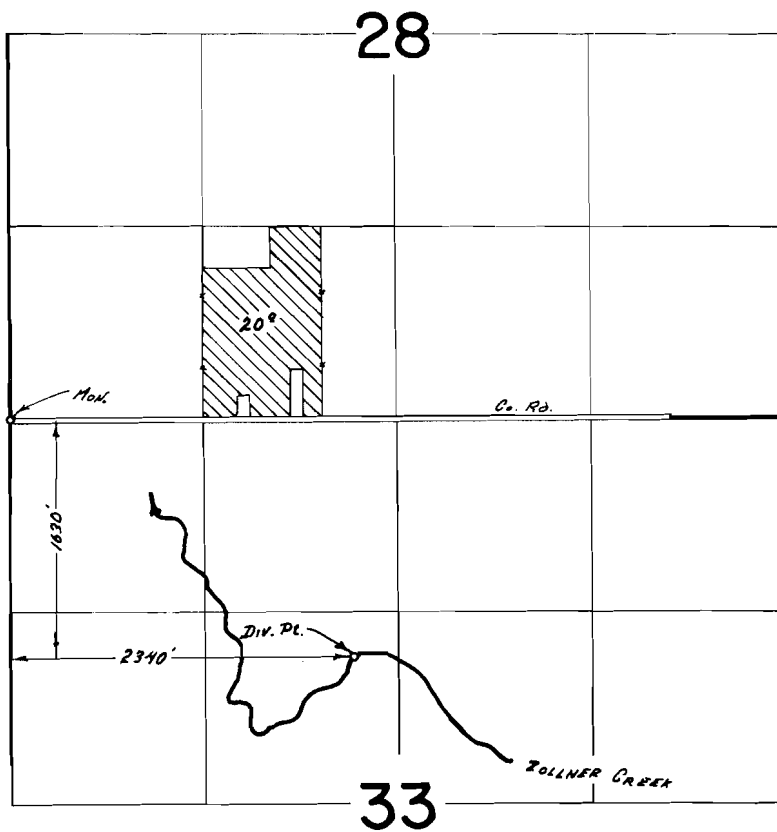

FINAL PROOF SURVEY
UNDER

Application No. 45752 Permit No. 34151
IN NAME OF

ROBERT F FESSLER

Surveyed APRIL 27 19 79, by R. D. MUCKEN