


T.9S. R.4W. W.M.

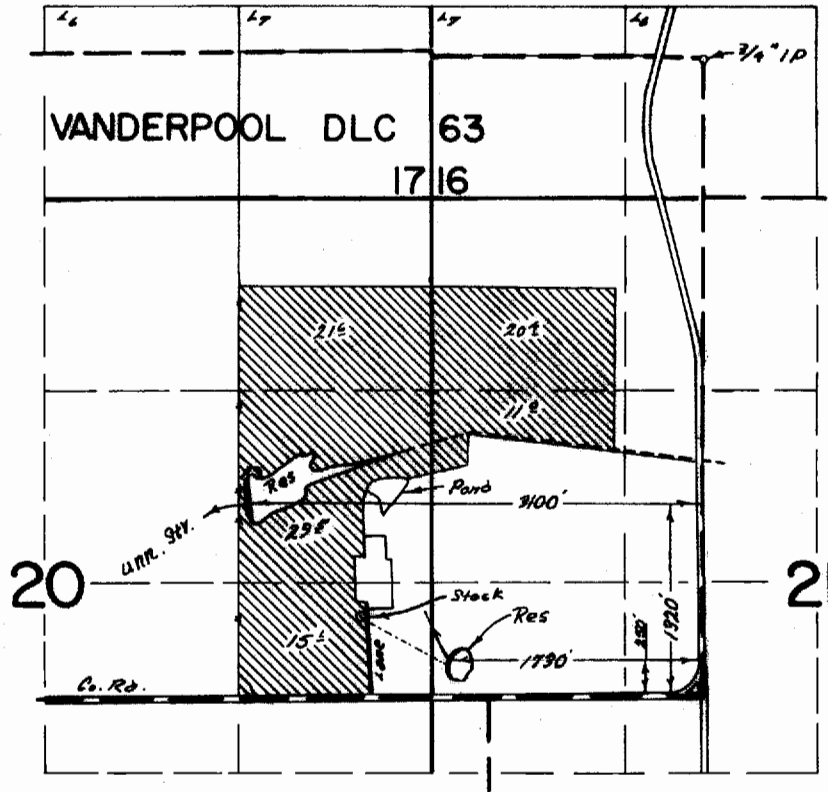

FINAL PROOF SURVEY
UNDER

46517
R-46516
46515

34802
R-5580
34753

Application No. R-46516 Permit No. R-5580
IN NAME OF

PATRICK A. OGLE

Surveyed March 21 1979, by R. G. Mucken