


T.9S. R.4W. W.M.

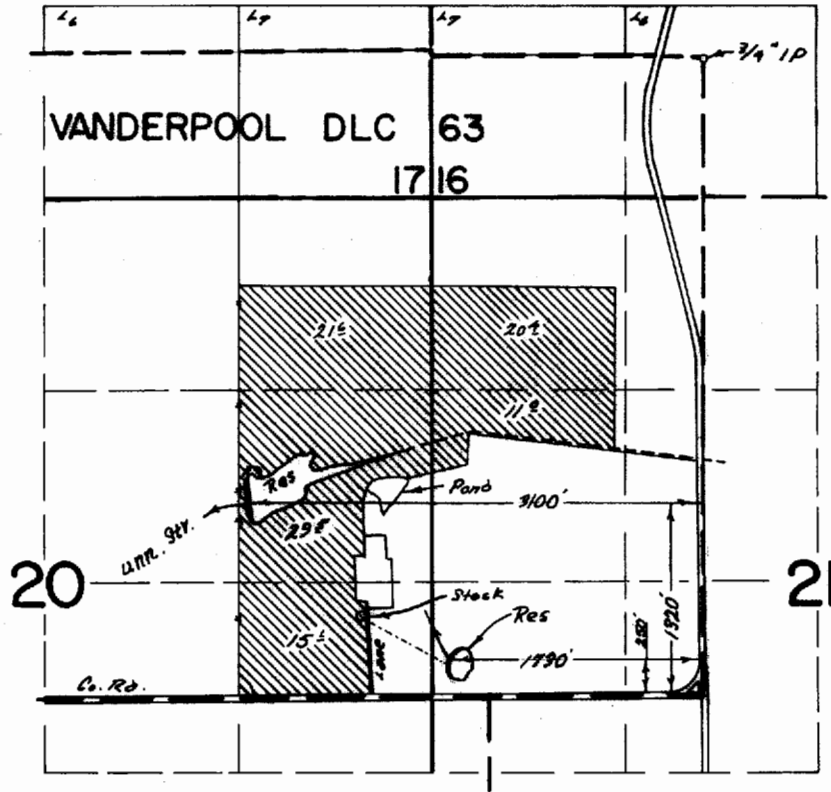

**FINAL PROOF SURVEY**  
UNDER

46517  
R-46576  
46515

34802  
R-5580  
34753

Application No. R-46517 Permit No. R-5586  
IN NAME OF

PATRICK A. OGLE

Surveyed March 21 1979 by R. G. Mucken