


T.2S.,R.38E.,W.M.

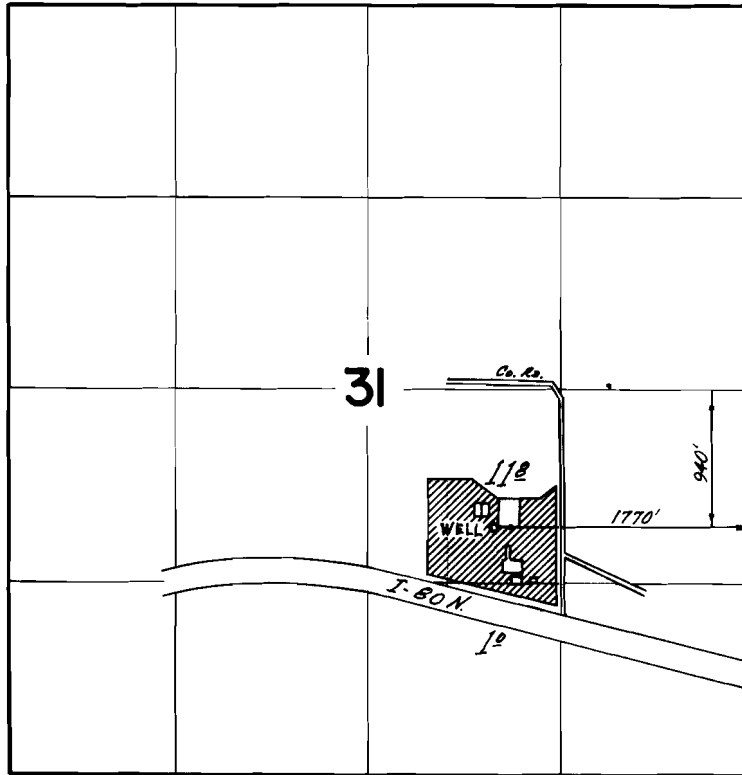

FINAL PROOF SURVEY
UNDER

Application No. G-4151 Permit No. G-3903
IN NAME OF

UNION COUNTY FAIR ASSOCIATION

Surveyed July 18, 1973, by D. Noray