


T. 1 N., R. 4 W., W.M.

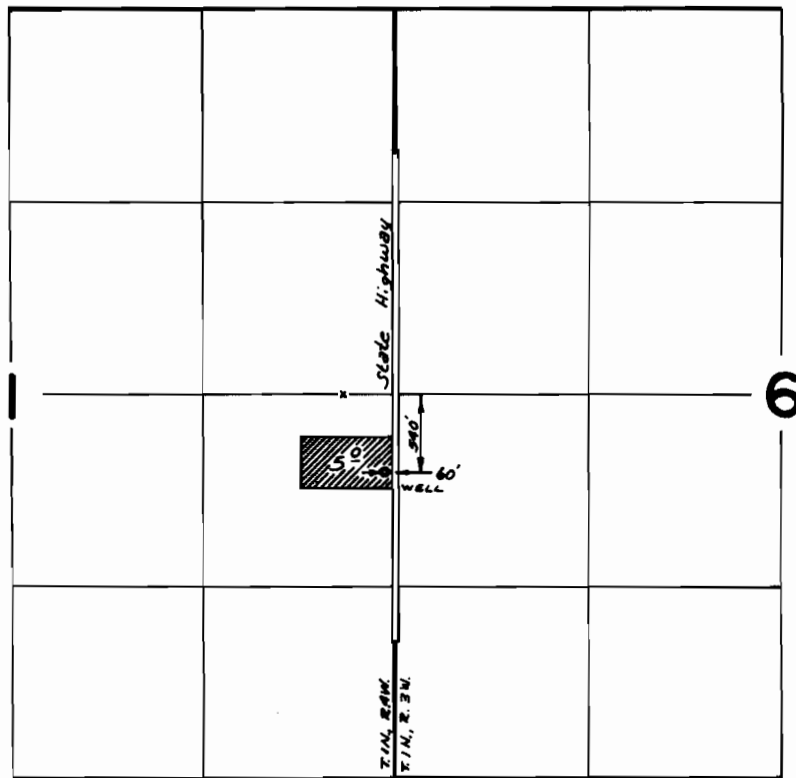

FINAL PROOF SURVEY
UNDER

Application No. G-3943 Permit No. G-3700
IN NAME OF

NORBERT J. KRIEGER

Surveyed June 5 1972, by L. E. Gould