


T.2N.R.28&3W.W.M.

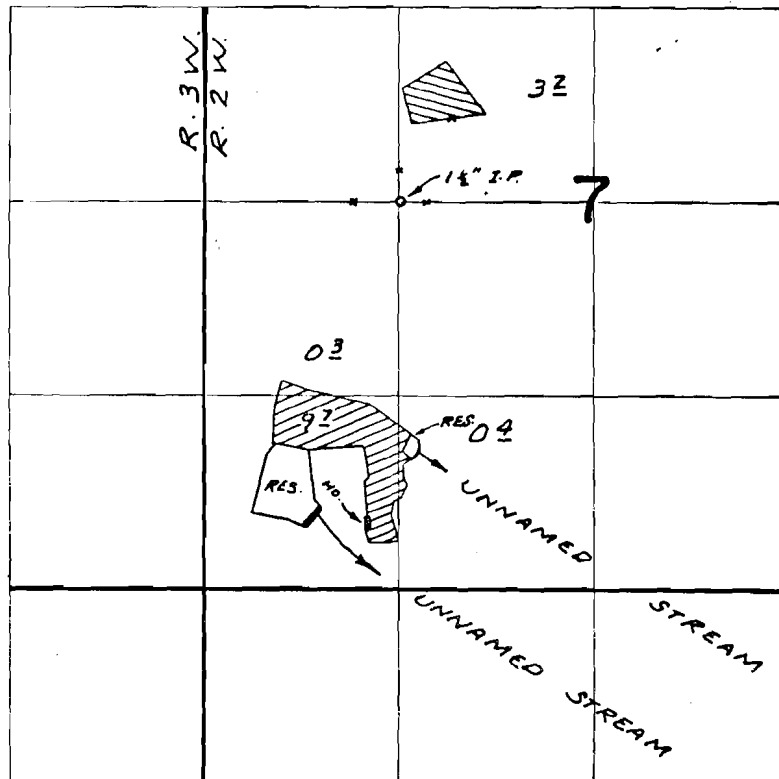

DIV. PTS. LOC. 2120'S. & 580'W; 1700'S. & 170'E, BOTH
FROM N.E. COR. NW 1/4 SW 1/4 SEC. 7

PERMIT 43930  PERMIT 43394 

FINAL PROOF SURVEY UNDER

Application No. R-43929 Permit No. R-5099
43930 32985
R-43393 R-4959
43394 32761
 IN NAME OF

HENRY B. CARLSON

Surveyed SEPT. 20 1972, by R. MUCKEN