


T.2N.R.28&3W.W.M.

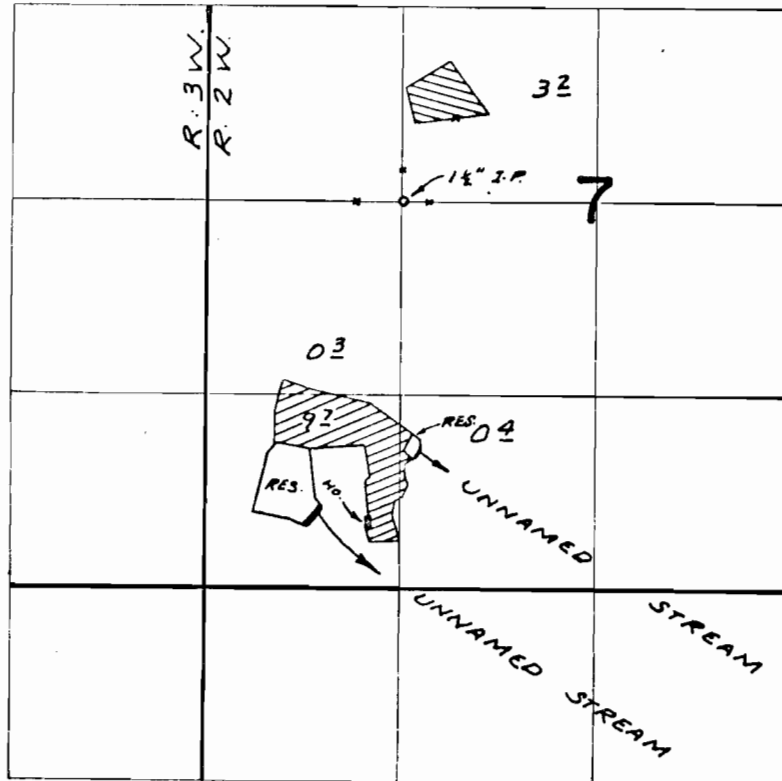

DIV. PTS. LOC. 2120'S. & 580'W; 1700'S. & 170'E, BOTH FROM N.E. COR. NW 1/4 SW 1/4 SEC. 7

PERMIT 43930  PERMIT 43994 

FINAL PROOF SURVEY UNDER

Application No. 43929 Permit No. 32985
43930 32985
43993 32985
43994 32985
 IN NAME OF

HENRY B. CARLSON

Surveyed SEPT. 20 1972, by R. MUCKEN