


T.2N.R.283 W.W.M.

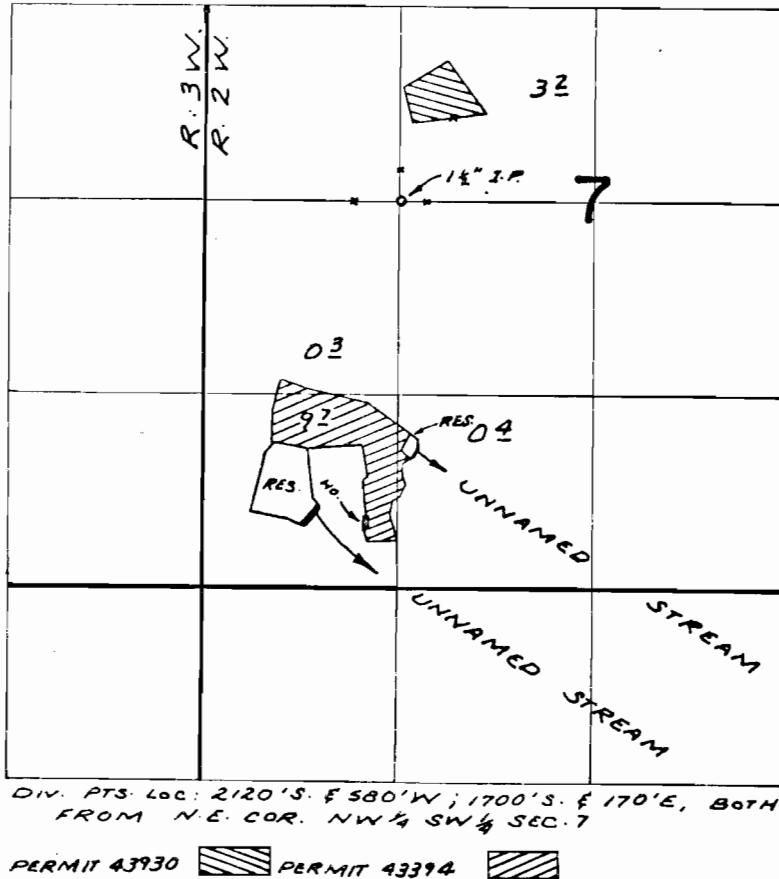

FINAL PROOF SURVEY
UNDER

Application No. 43394 Permit No. 32361
IN NAME OF

HENRY B. CARLSON

Surveyed SEPT. 20 1972, by R. MUCKEN